

Engineering Review

Statement on Approval Dwgs:

It is understood that sprinkler branch lines, 4" diameter and smaller have already been considered in the total uniform loading given on structural drawings for the joist and girder design. No additional loads or load cases will be considered for joists supporting these pipes. It is recognized that the girder loading given already considers all possible joist reactions from all gravity load combinations and types, and no other additional concentrated loads will be considered. Only mains above 4" diam. pipe will be considered as additional load in joist design. CSC intends to proceed with joist product design in this manner unless instructed otherwise on approval return.

Review Comments to Detailer:

1. Net Uplift per diagrams on S2.31, see below and combine uplift zones as follows.
 - **Mezzanine joists are to be designed with ZERO uplift.** (Detail NO uplift rows.)
 - **For Joist Interior (Zone 1') = -10.5 PSF**
 - **For Joist Perimeter (Zone 1) = -18.0 PSF**
 - **For Joist Perimeter = -27.0 PSF**
 - **For All Girders = -12.8 PSF** (Use for everywhere, do NOT break out for strip.)
2. Use standard end anchorage welds. (K-Series: 1/8" x 2 1/2", LH-Series: 1/4" x 2 1/2"). Review required by final design.
3. Equally space bridging between the supports. (Top and Bottom Chord bridging aligned)
4. Rooftop equipment units are shown on the framing plan. These loads are in addition to the joist design and must be transferred to the girder panel points. Please note these loads on the joist and girder BOMs.
5. Section 2/S1.12 indicates joists supporting rooftop units are subject to snow drift loads. Please note these snow drifts, as needed, in addition to the rooftop units on the joist BOMs. These drift loads must also be transferred to the girder panel points.
6. 44LHSP joists between grids B&A and M&N are to be designed for a minimum moment of inertia of 1,450 in⁴. Please note this minimum moment of inertia on the joist BOM's.
7. Section 7 & 7A/S4.01 indicates joists at Gridline B will bear on field-supplied bearing for a 'Speed Bay' expansion joint. We will need to adjust clearances to accommodate.
8. Per Roof Framing Plan Note 6.E on S2.20, perimeter joists are to be designed to resist rollover forces of 3.25 Kips Wind and 2.0 Kips Seismic along grids A & L. Please note these rollover forces on the joist BOMs.
9. Per Roof Framing Plan Note 6.F on S2.20, ALL joists between grids A&B and K&L are to be designed for axial loads: 4.0 Kips Wind and 7.5 Kips Seismic. These loads appear to be through the joist seats unless noted otherwise.
10. Per Roof Framing Plan Notes 6.I & 7.F on S2.20, joists and girders are to be designed for a live load deflection of L/360 for office areas and L/240 for typical areas. Please note this on the joist and girder BOMs.
11. Per Roof Framing Plan Note 7.A on S2.20, Self-weight of the girders is in addition to design. Please note this on the girder BOMs.
12. Per Roof Framing Plan Note 7.B on S2.20, ALL girders are to be designed for a single 2.0 Kip load at any bottom chord panel point along the girder chords. Please note this on the girder BOMs.
13. Snow drift loads are shown at the roof perimeter, these loads are in addition to the joist design. Please show these loads on the layout drawings and note them on the joist BOMs. Also note the snow drift reactions from the girder panel points as shown on the framing plan on the girder BOMs.

14. OK to assume sprinkler branch lines (4" Ø & smaller) have already been considered in the joist and girder loads shown but MAINS (Greater than 4" Ø) are in addition to the joist design and must be transferred to the girder panel points. See response to approval statement above.
15. Bridging per ESFR Sprinkler Lines, see CAD file in the job reviews folder for joist profiles and include on the layout drawings.
16. Add the following notes to the approval drawings:

ERECTOR NOTE: Erector, locate bridging to meet fire marshal code clearances required for ESFR sprinkler system function. Bridging location tolerance is +or- 4". Contact CSC if bridging locations shown on plans or proper clearances cannot be achieved.

SPRINKLER INSTALLER NOTE: ESFR feeder lines may require slight adjustment from plan dimensions to clear some confined joist web members. Check with Fire Protection designer for limits on amount of adjustment.

NOTE: Do not use APPROVAL drawings for joist and bridging erection


SPRINKLER INSTALLER NOTE: ALL sprinkler mains, 4" and larger, shall have connections to joists be hung concentrically achieved by loading thru the center of gravity of a single joist and/or by trapeze type hanger. Side mounting mains to a single joist is prohibited.

17. OK to modify our field strut detail to match the section 7/S1.11 and show a max allowable distance of 4" for a concentrated load to occur away from a panel point before a field strut is required. No approval statement required for this.

Design/ Engineering notes:

1. Steffy Project – Make sure to adhere to all design standards including special joist grouping by requisition:
 - The Tie Joists (TJ's) should be in a req separate from the 'infill' joists. The req's for the infill joists need to have a note on the cap sheets for 'Bundle in groups of 8, or 4 and 4'.... or Bundle in groups of 7, or 3 then 4'.
2. Girder self-weight is in addition to design. Apply self-weight to girder bottom chords.
3. See above & returned approvals.

ESFR Profiles

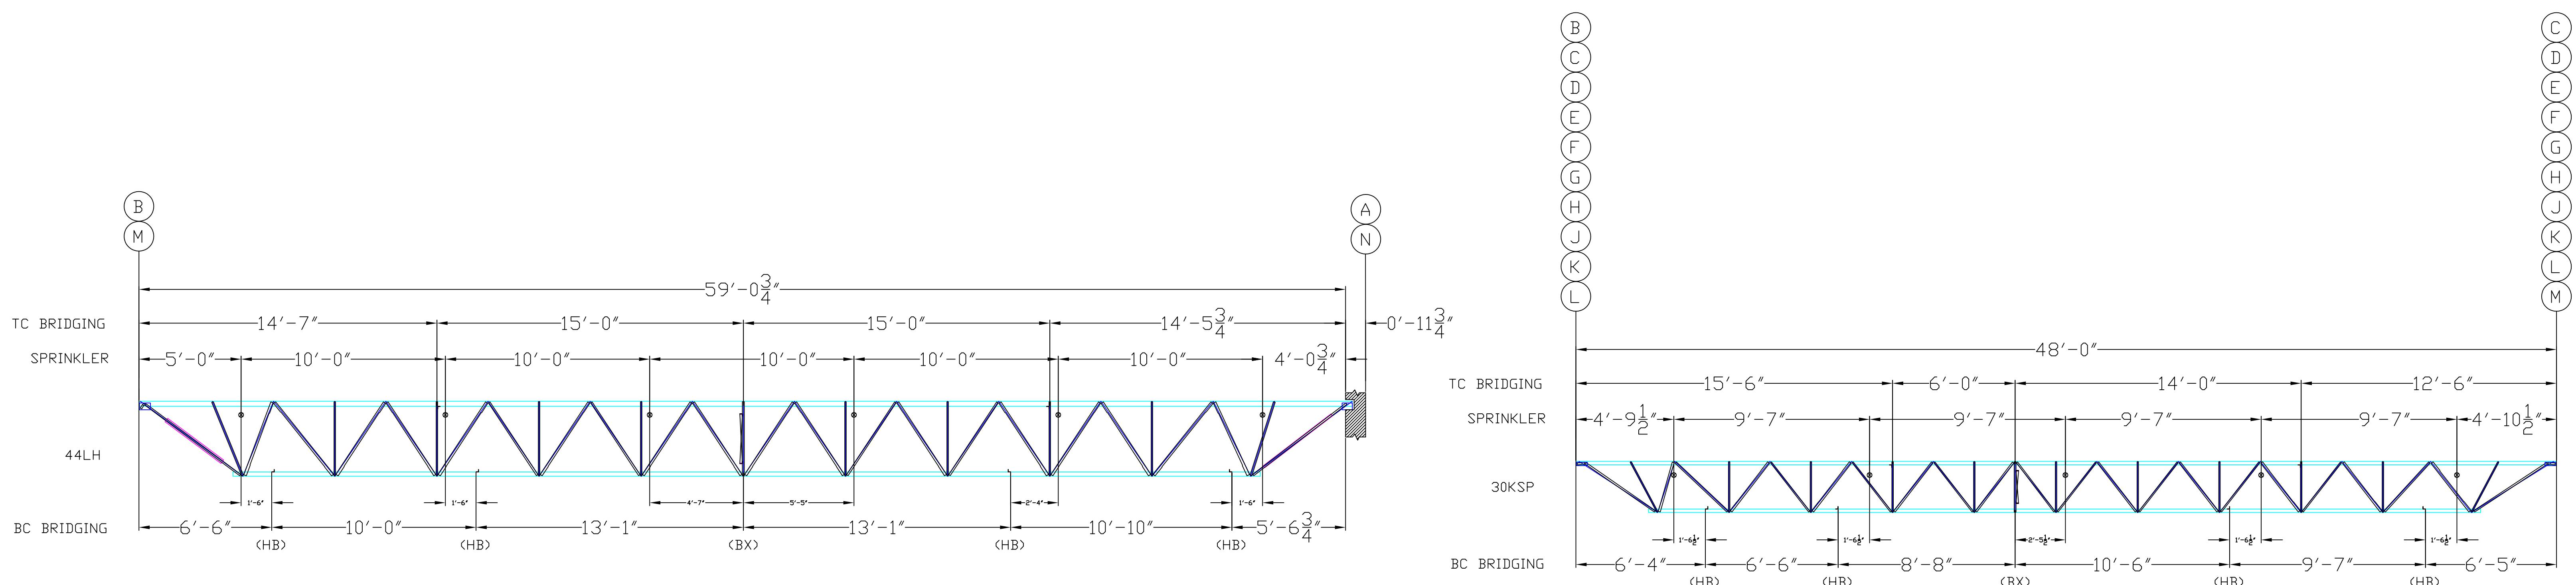


CROSS-BRIDGING STUDS SYSTEM


CROSS-BRIDGING STUDS SYSTEM

EACH CROSS-BRIDGING (X-BRDG) SET HAS TO BE INSTALLED AND BOLTED SEPARATELY.



STEP 1 : INSTALL THE FIRST X-BRDG SET TO THE JOIST WITH TWO LOW PROFILE NUTS. (NO WASHERS RQD AT LOW PROFILE NUTS)

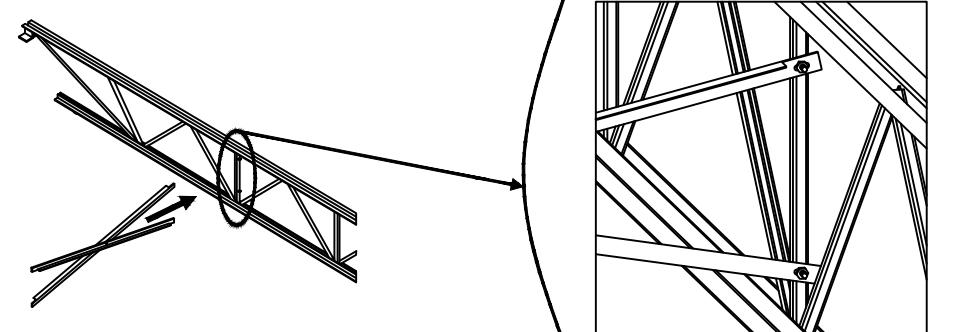

STEP 2 : INSTALL THE SECOND X-BRDG SET ON THE OTHER SIDE OF THE JOIST WITH TWO ADDITIONAL LOW PROFILE NUTS (NO WASHERS RQD).

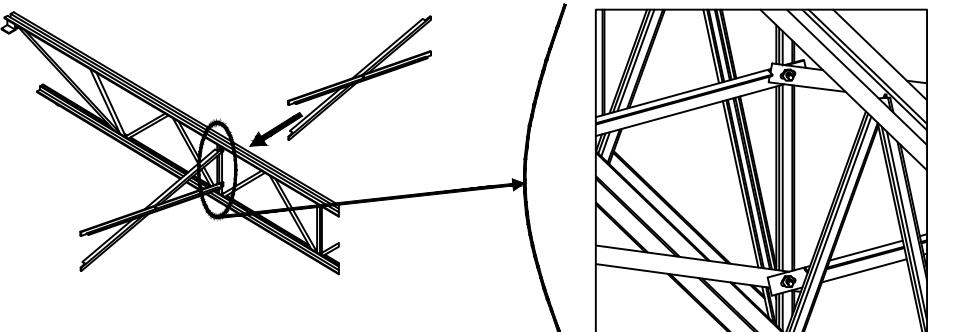


RESULT: TWO BRDG PIECES ARE MAINTAINED AT EACH STUD WITH TWO SEPARATE LOW PROFILE NUTS. A CROSS-BRIDGING (X-BRDG) SET IS INSTALLED ON EITHER SIDE OF THE JOIST.

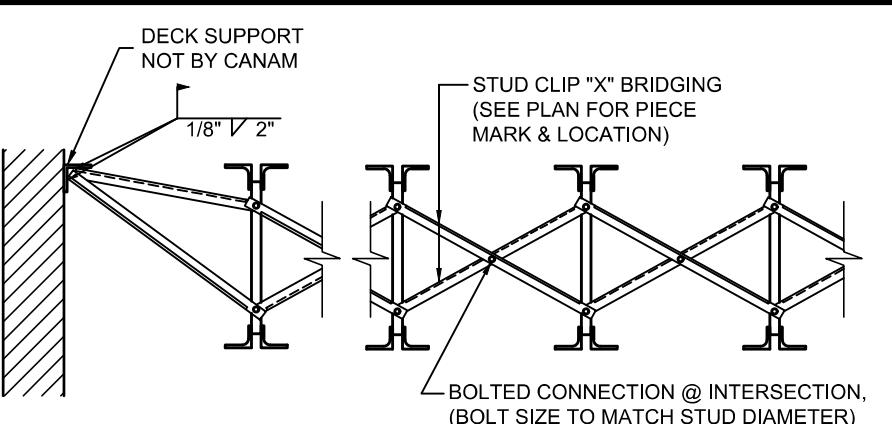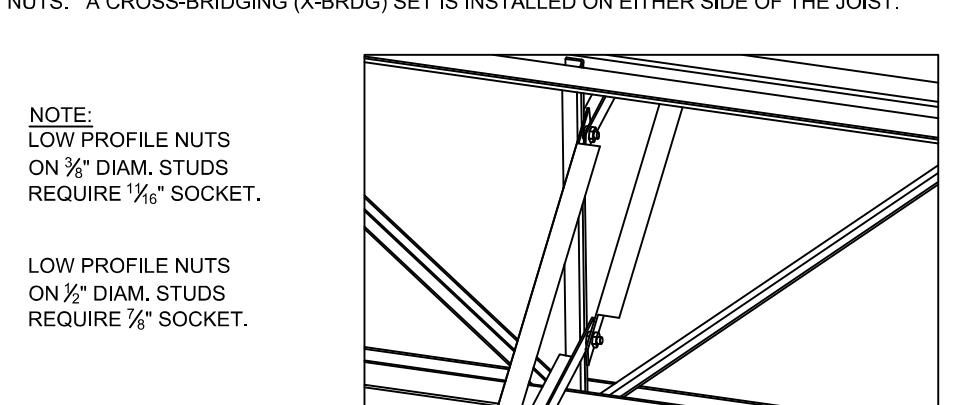


TYPICAL CROSS BRIDGING ON STUD CLIP


NOTE: USE WASHERS EXCEPT UNDER FLANGED BOLT HEADS OR LOW PROFILE OVER-WIDTH NUTS.

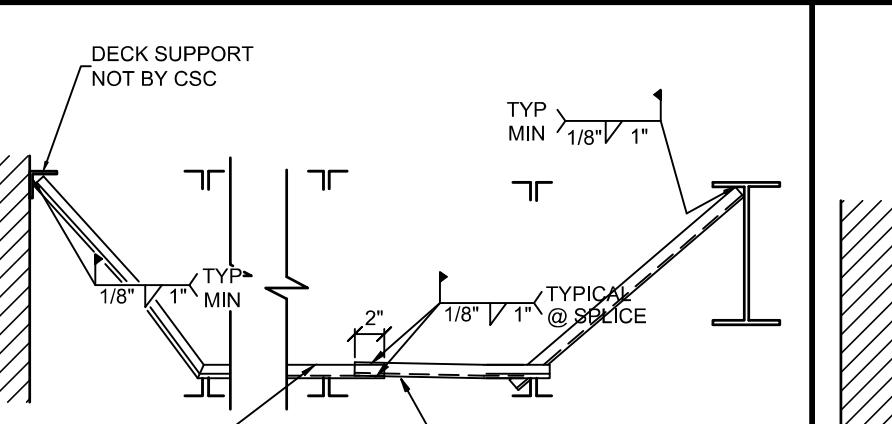

TYPICAL UPLIFT BRIDGING

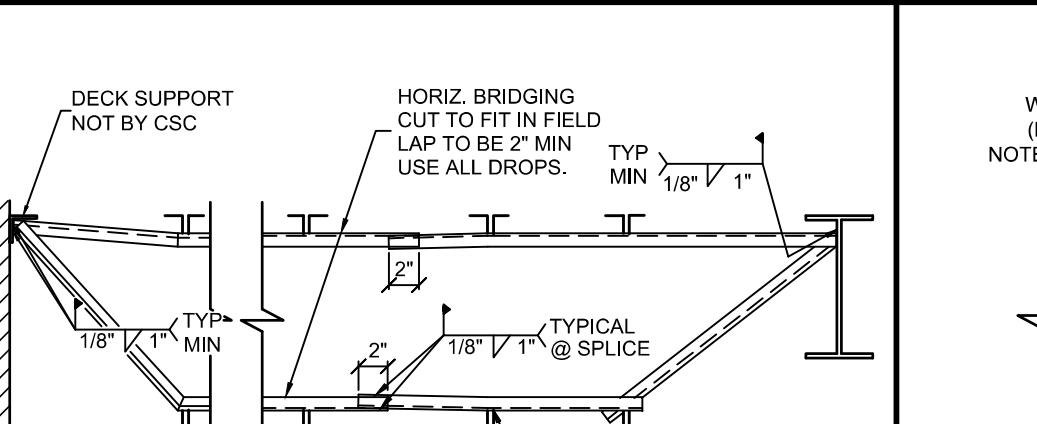


TYPICAL HORIZONTAL BRIDGING

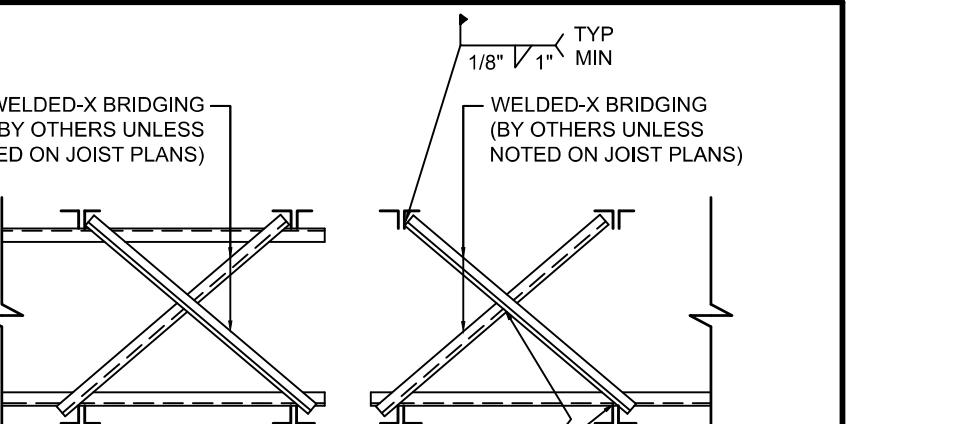

TYPICAL BRIDGING TERMINUS


KEY NOTE	K-SERIES & LH SERIES 02-06	LH SERIES & 07-17 DLH SERIES 10-17	DLH-SERIES 18-25	CJ SERIES SEAT DEPTH ≥ 5"	JOIST GIRDERS
(A)	2"	4"	6"	4"	4"
* (B)	7"	9"	13"	9"	9"

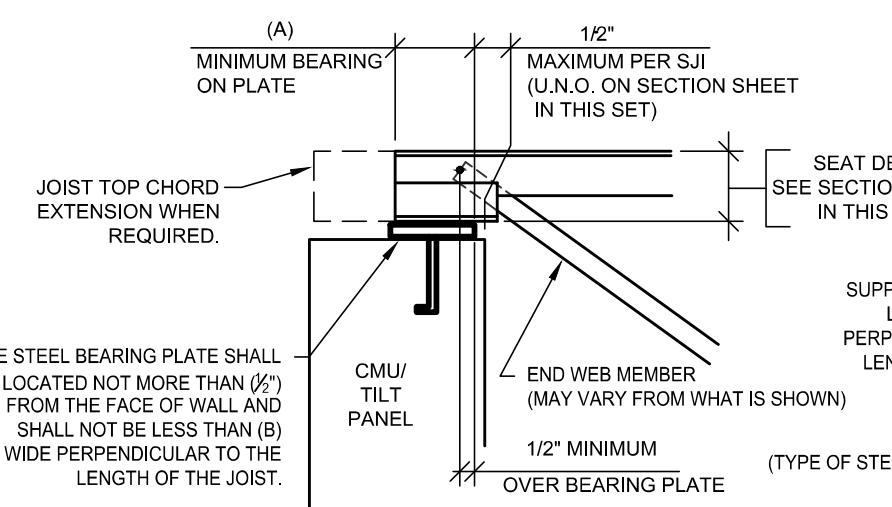

MINIMUM JOIST BEARING DETAIL

SEE THE PROJECT SPECIFIC SECTIONS WITHIN THIS SET FOR EXACT JOIST PLACEMENT. THIS SECTION CONVEYS THAT SJII MINIMUM BEARING LENGTHS AND TYPICAL WIDTH ALLOWANCES SHALL BE RESPECTED UNLESS SPECIFICALLY COORDINATED OTHERWISE WITH CANAM.



ERECTOR NOTE:
JOIST SEATS FABRICATED TO ALLOW FOR BOLTED ANCHORAGE ALSO REQUIRE A FINAL WELDED CONNECTION, BUT THE BOLTS SHALL BE INSTALLED, IF BOLTS ARE NOT INSTALLED, AND IF PERMITTED BY THE EOR, THEN THE INSIDE EDGE OF THE SEAT SLOTS MUST BE WELDED, AS SHOWN, ADDITIONAL WELD AS REQUIRED TO MEET THE TOTAL SPECIFIED SHALL BE PLACED AT A LOCATION ON THE EDGE OF THE SEAT AWAY FROM THE OUTER EDGE OF THE SLOT.

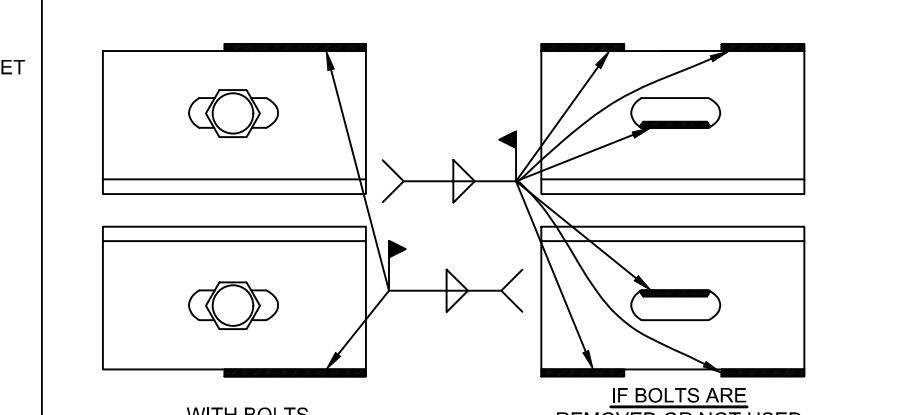

BOLTED JOIST CONNECTION DETAIL

FOR NOMINAL CONCENTRATED LOADS BETWEEN PANEL POINTS, WHICH HAVE BEEN ACCOUNTED FOR IN THE SPECIFIED CONCENTRATED LOADS, STRAIN TO TRANSFER THE LOAD TO A POINT ON THE UPPER CHORD SHALL NOT BE REQUIRED, PROVIDED THE SUM OF THE CONCENTRATED LOADS WITHIN A CHORD PANEL DOES NOT EXCEED 100 POUNDS AND THE ATTACHMENTS ARE CONCENTRIC TO THE CHORD.

**TYPICAL INSTALLATION DETAIL FOR:
JOIST REINFORCEMENT AT CONCENTRATED LOADS**
REFERENCE: 7S1.11

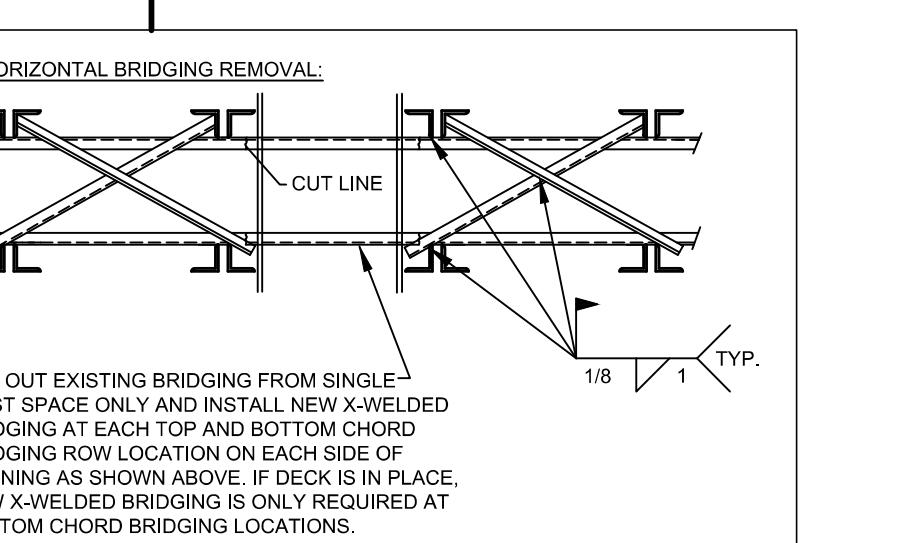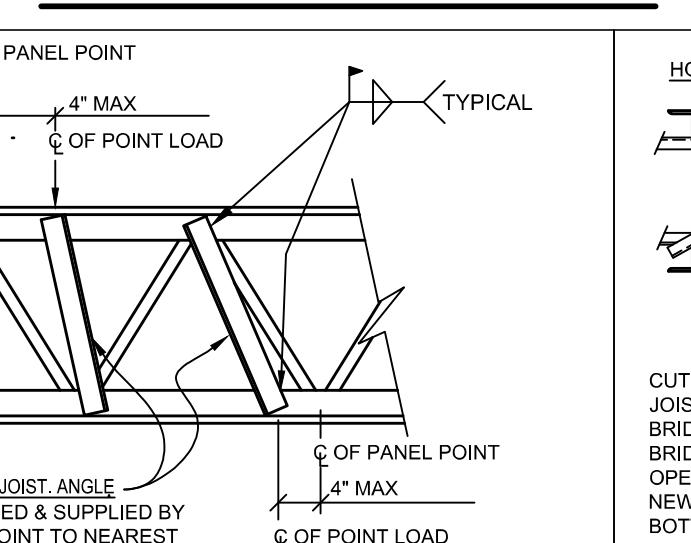

HORIZONTAL BRIDGING REMOVAL:
CUT OUT EXISTING BRIDGING FROM SINGLE JOIST SPACE ONLY AND INSTALL NEW X-WELDED BRIDGING AT EACH TOP AND BOTTOM CHORD OPENING AS SHOWN ABOVE. IF DUE TO THE POSITION OF THE EXISTING X-WELDED BRIDGING, IT IS REQUIRED TO REMOVE THE EXISTING X-WELDED BRIDGING AND RELOCATE IT TO ANOTHER POSITION.

NOTE:
X-WELDED BRIDGING SHOWN ABOVE IS NOT BY CANAM.

BOLTED X-BRIDGING REMOVAL NOTE:
AFTER JOIST ERECTION, BOLTED X-BRIDGING MAY BE REMOVED FROM A SINGLE JOIST SPACING. IF BOLTED X-BRIDGING REMOVAL IS REQUIRED IN TWO CONSECUTIVE JOIST SPACINGS, CONTACT CANAM ENGINEER.

**SINGLE JOIST SPACE
DISCONTINUOUS BRIDGING PLACEMENT**
REFERENCE: 7S1.11

AVAILABLE CONTRACT DRAWINGS

DWG. #	DWG. DATE	DWG. #	DWG. DATE
S0.0	5/16/2025	S2.00H	10/14/2024
S0.1	5/16/2025	S2.10	5/16/2025
S0.2	10/14/2024	S2.11	5/16/2025
S0.3	10/14/2024	S2.20	10/14/2024
S0.4	10/14/2024	S2.20A	5/16/2025
S0.5	10/14/2024	S2.20B	5/16/2025
S1.01	10/14/2024	S2.20C	5/16/2025
S1.02	10/14/2024	S2.20D	5/16/2025
S1.03	10/14/2024	S2.20E	5/16/2025
S1.11	10/14/2024	S2.20F	5/16/2025
S1.12	10/14/2024	S2.20G	5/16/2025
S2.00	10/14/2024	S2.30	5/16/2025
S2.00A	10/14/2024	S2.31	10/14/2024
S2.00B	10/14/2024	S2.32	10/14/2024
S2.00C	10/14/2024	S2.33	5/16/2025
S2.00D	10/14/2024	S3.01	5/16/2025
D2.00E	10/14/2024	S4.01	5/16/2025
S2.00F	10/14/2024	S5.00	10/14/2024
S2.00G	10/14/2024	S6.00	10/14/2024

DRAWING INDEX

SHEET. #	DWG. NAME
JE1.01	JOIST COVER - TITLE PAGE
JE2.01	JOIST FRAMING PLAN 'A'
JE2.02	JOIST FRAMING PLAN 'B'
JE2.03	JOIST FRAMING PLAN 'C'
JE2.04	JOIST FRAMING PLAN 'D'
JE2.05	JOIST FRAMING PLAN 'E'
JE2.06	JOIST FRAMING PLAN 'F'
JE2.07	JOIST FRAMING PLAN 'G'
JE2.08	JOIST FRAMING PLAN 'H'
JE2.09	JOIST FRAMING PLAN MEZZANINE
JE3.01	JOIST SECTIONS
JE3.02	JOIST/BRIDGING DIAGRAM
JE3.03	UPLIFT DIAGRAM

GENERAL NOTES

1. ANY DISCREPANCY IN DIMENSIONS, DETAILS, OR FABRICATION DISCOVERED DURING ERECTION SHALL BE BROUGHT TO THE IMMEDIATE ATTENTION OF CANAM STEEL CORPORATION, WHO SHALL HAVE THE OPTION OF EXAMINING THE PROBLEM AT THE JOBSITE BEFORE ANY CORRECTIVE MEASURES ARE UNDERTAKEN. ALL REPAIRS AND REQUIRED ADDITIONAL EXPENSE MUST BE AUTHORIZED IN WRITING BY CANAM STEEL CORP., BEFORE ANY REPAIR WORK IS PERFORMED. CANAM STEEL CORP. WILL NOT BE RESPONSIBLE FOR ADDITIONAL EXPENSES FOR CORRECTIVE MEASURES UNDERTAKEN WITHOUT PRIOR APPROVAL.

2. ALL PRODUCTS PROVIDED BY CANAM STEEL CORPORATION IN CONNECTION WITH THIS DRAWING ARE SUBJECT TO CANAM STEEL CORPORATION'S STANDARD TERMS AND CONDITIONS FOR CANAM PRODUCT SALES. BY ACCEPTING THE PRODUCTS, THE PURCHASER ACKNOWLEDGES THAT THEY HAVE RECEIVED AND REVIEWED THESE TERMS AND CONDITIONS.

3. THE ISSUANCE OF THIS DRAWING DOES NOT CONSTITUTE THE ACCEPTANCE OF A CUSTOMERS ORDER.

4. © 2021, CANAM STEEL CORPORATION. UNAUTHORIZED USE OF THIS DRAWING AND INFORMATION PROVIDED HEREIN IS STRICTLY FORBIDDEN.

5. CANAM'S ERECTION DRAWINGS HEREIN WERE PREPARED USING THE STRUCTURAL PORTION OF THE CONTRACT DRAWINGS AS ITS PRIMARY GUIDE AND USING THE ARCHITECTURAL DRAWINGS (WHERE PROVIDED) ONLY FOR MISCELLANEOUS OR OTHER CLARIFICATION. CANAM DOES NOT ACCEPT ANY RESPONSIBILITY FOR DISCREPANCIES BETWEEN THE STRUCTURAL AND ARCHITECTURAL DRAWINGS.

6. THESE DRAWINGS ARE TO BE USED ONLY FOR THE ERECTION OF PRODUCTS SUPPLIED BY CANAM STEEL CORPORATION AS INDICATED BY AN ERECTION MARK ON THE PLANS AND/OR SECTIONS.


7. CANAM STEEL CORPORATION IS NOT RESPONSIBLE FOR HANDLING AND ERECTION OF MATERIALS IT SUPPLIES. THE DESIGN AND MANUFACTURE OF THE MATERIALS ASSUMES THAT THEY ARE HANDLED IN ACCORDANCE WITH ALL APPLICABLE LAWS AND REGULATIONS. CANAM STEEL CORPORATION IS NOT RESPONSIBLE FOR ANY MISHANDLING OR FAILURE TO PROPERLY ERECT THE MATERIALS.

8. CANAM STEEL CORPORATION HAS NOT EXAMINED ANY FIELD CONDITIONS AND ASSUMES NO RESPONSIBILITY FOR ANY SITE CONDITIONS. PURCHASER MUST NOTIFY CANAM STEEL CORPORATION OF ANY DISCREPANCIES BETWEEN THE FIELD CONDITIONS AND CANAM STEEL CORPORATION'S FIELD USE DRAWINGS.

9. ANY MODIFICATION OF MATERIAL SUPPLIED BY CANAM STEEL CORPORATION WITHOUT PRIOR WRITTEN CONSENT WILL AUTOMATICALLY RELEASE CANAM FROM ALL LIABILITY WITH RESPECT TO SUCH MATERIAL.

DRAWING LEGEND	
(00'-0") = ELEVATION	TC = TOP CHORD
(00'-0") = ELEVATION (WHEN NON-STANDARD)	BC = BOTTOM CHORD
(00'-0") = AXIAL LOADS	EOD = END OF GIRDER
(E) = ERECTION STABILITY BRIDGING (MUST BE IN PLACE PRIOR TO RELEASING THE HOISTING LINES.)	EJ = END OF JOIST
(P) = PULL LOAD (OUNT WRIGHT WRITTEN ABOVE THE LINE)	JBE = JOIST BEARING ELEVATION
(T) = TIE JOIST	DT = DANGER JOIST - NOT DESIGNED TO SUPPORT CONCENTRIC LOADS WITHOUT BRIDGING INSTALLED. SEE ERECTOR NOTES FOR ADDITIONAL INFORMATION.
(S) = SPECIAL LOAD CONNECTION	TJ = TIE JOIST
(D) = DESIGNER JOIST CONNECTION	BJ = BOTTOM OF JOIST
(G) = GIRDERS	BC = BOTTOM CHORD
(C) = INDICATES X-WELDED BRIDGING TO BE PLACED AT FIRST BOTTOM CHORD PANEL POSITION. THE X-WELDED BRIDGING IS TO BE EQUALLY SPACED BETWEEN THE FIRST BOTTOM CHORD PANEL POINTS.	BC = BACK OF CHAN
(W) = ELEVATION CHANGE	FOW = INSIDE FACE OF WALL
(E) = EXPANSION JOINT	EJ = EXPANSION JOINT
(V) = VERIFY IN FIELD	VIF = VERIFY IN FIELD

REVISION NO.	DATE	DESCRIPTION

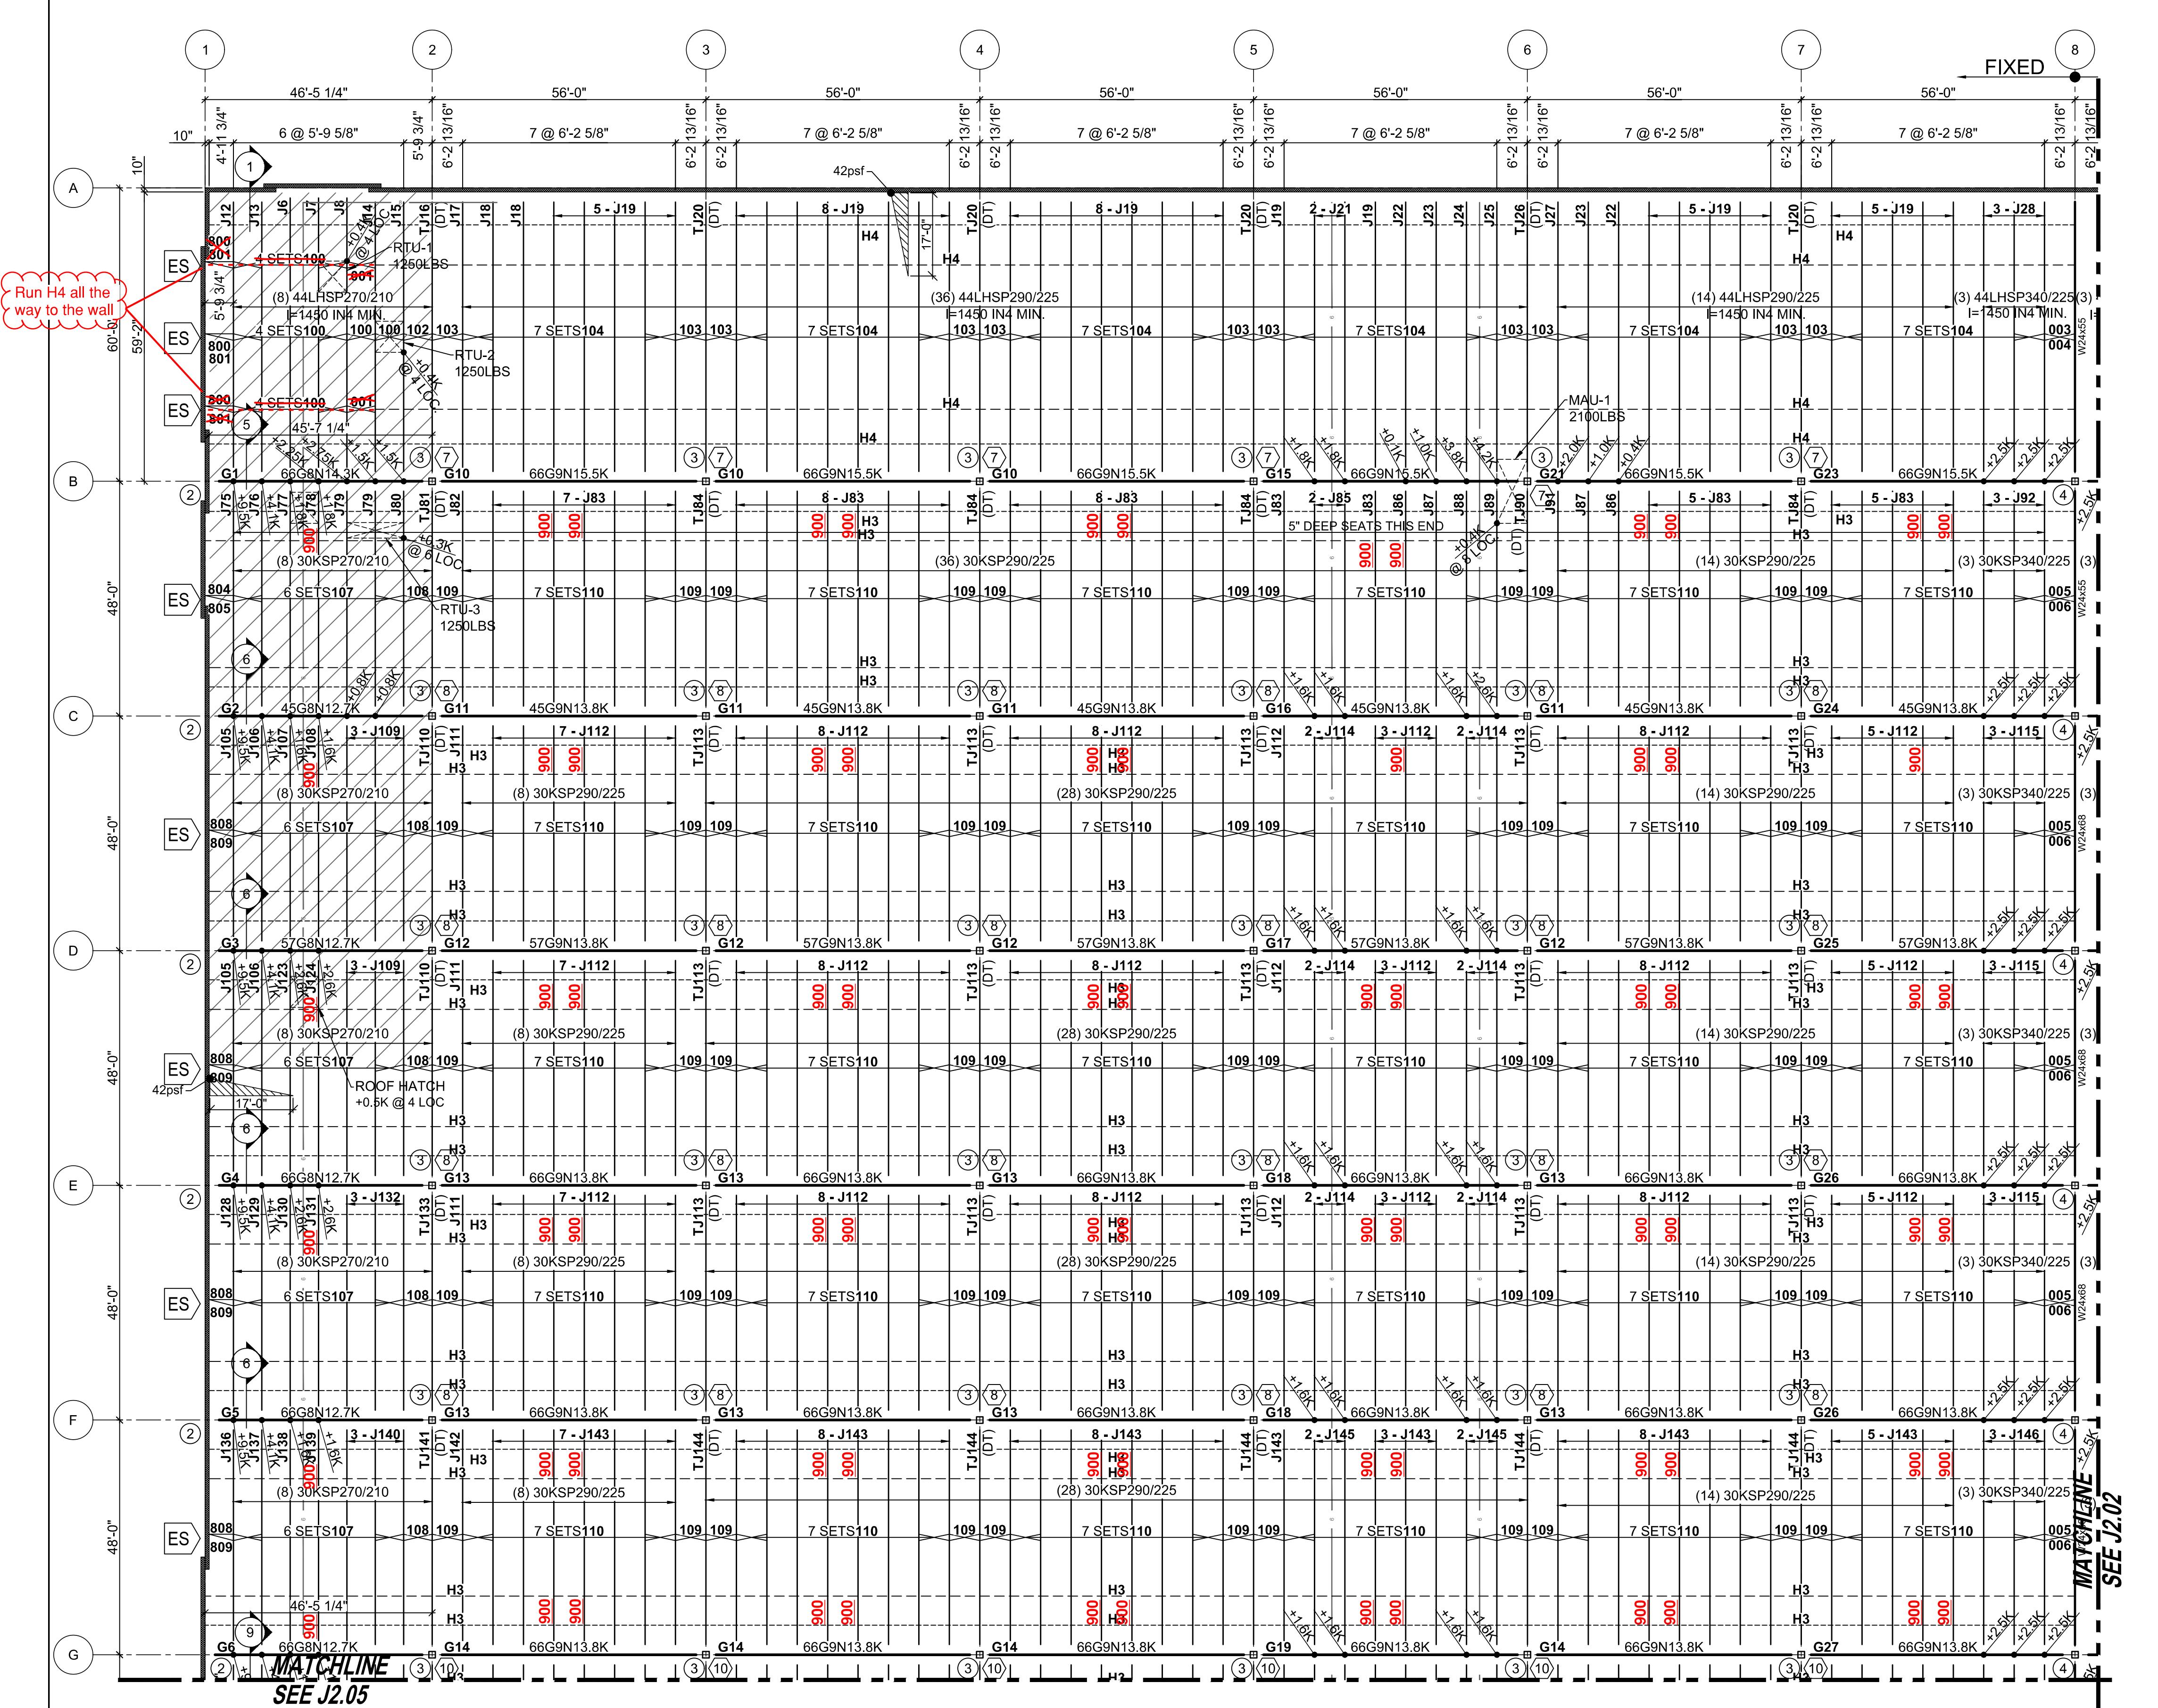

ES = ERECTION STABILITY BRIDGING (MUST BE IN PLACE PRIOR TO RELEASING HOISTING LINES.)

- — CONT. HORIZONTAL BRIDGING TYP @ TOP AND BOTTOM CHORDS.
H3= L1 1/2x1 1/2x0.109
H4= L1 3/4x1 3/4x0.143
- BOLTED-X BRIDGING L1 1/4x1 1/4x0.109
- WELDED-X BRIDGING L1 1/4x1 1/4x0.109
- - - - UPLIFT BRIDGING TYP @ BOTTOM CHORD ONLY
H3= L1 1/2x1 1/2x0.109
H4= L1 3/4x1 3/4x0.143


NOTE: Do not use APPROVAL drawings for joist and bridging erection.

ERECTOR NOTE: See Sheet JE2.03 for placement of bridging at top and bottom chords to avoid conflict with ESFR.

ERECTOR NOTE: Erector, locate bridging to meet fire marshal code clearances required for ESFR sprinkler system function. Bridging location tolerance is +or- 4'. Contact Canam if bridging locations shown on plans and/or proper clearances cannot be achieved.

SPRINKLER INSTALLER NOTE: ESFR feeder lines may require slight adjustment from plan dimensions to clear some confined joist web members. Check with Fire Protection designer for limits on amount of adjustment.

SPRINKLER MAIN INSTALLER NOTE: ALL sprinkler mains, 4" and larger, shall have connections to joists be hung concentrically achieved by loading thru the center of gravity of a single joist and/or by trapeze type hanger. Side mounting mains to a single joist is prohibited.

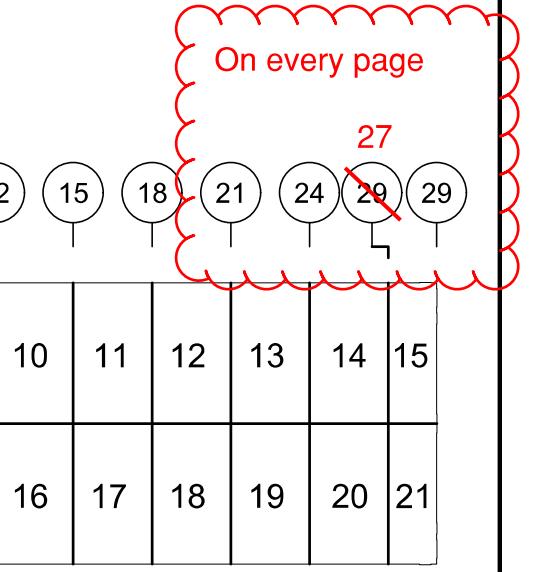

SEQUENCE PLAN

REVISION NO.	DATE	DESCRIPTION

**FOR APPROVAL ONLY
NOT FOR FIELD USE**


DATE SENT FOR FIELD USE:
DATE SENT FOR APPROVAL:

ROOF JOIST FRAMING PLAN 'A'
REF: S2.20A SEQ: SEE PLAN


1. REFERENCE DWG JE1.01 FOR LEGEND, SYMBOLS, & ABBREVIATIONS.
2. REFERENCE "TYPICAL JOIST REINFORCEMENT" DETAIL ON JOIST DRAWING JE1.01.
3. THE TAG END OF THE JOIST IS THE END AT WHICH THE PIECE MARK IS LOCATED.
4. FOR TYPICAL SEE DRAWING JE1.01.
5. ALL JOISTS WITH SPANS 40'-0" AND GREATER TO HAVE BOLTED CONNECTION.
6. ALL JOISTS AND JOIST GIRDERS BEARING Cols ARE HSS 12x12 UNO.
7. DENOTES JOIST CONNECTION (SEE JOIST SECTIONS).
8. DENOTES GIRDERS CONNECTION (SEE JOIST SECTIONS).
9. 900 - 920 KNEE BRACE ONLY IF REQ'D BY DESIGN. SEE PLAN FOR LOCATIONS.
10. DESIGN JOIST SEATS FOR 3.25K ROLLOVER (1.0 WIND) & 2.0K (1.0 EARTHQUAKE) @ GRIDLINES A & N.
11. INDICATES SNOW DRIFT.
12. ALL JOIST ENDS AND TOP CHORDS TO BE DESIGNED FOR AXIAL FORCE OF 4.0K (1.0 WIND) AND 7.5K (1.0 EARTHQUAKE) FOR JOISTS BETWEEN LINE A & B AND M & N.
13. LIMIT JOIST & GIRDERS DEFLECTION TO L/240 UNDER LIVE OR SNOW LOAD AND L/360 AT OFFICE AREAS WHERE INDICATED ON PLAN.

NET UPLIFT = SEE DIAGRAM
ON DWG JE3.03

ADDITIONAL BRIDGING DUE TO UPLIFT
SEE JE3.02 FOR JOIST/BRIDGING DIAGRAM

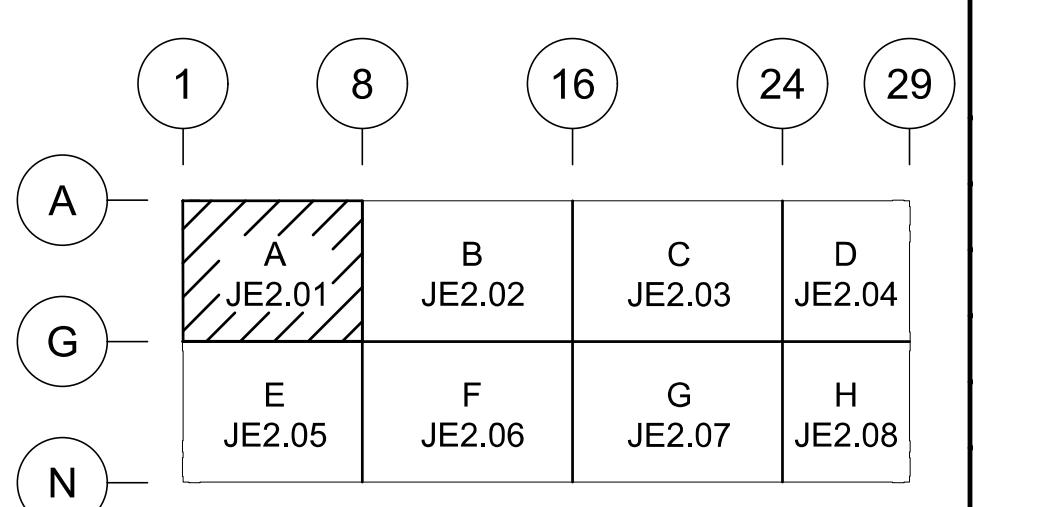

KEY PLAN

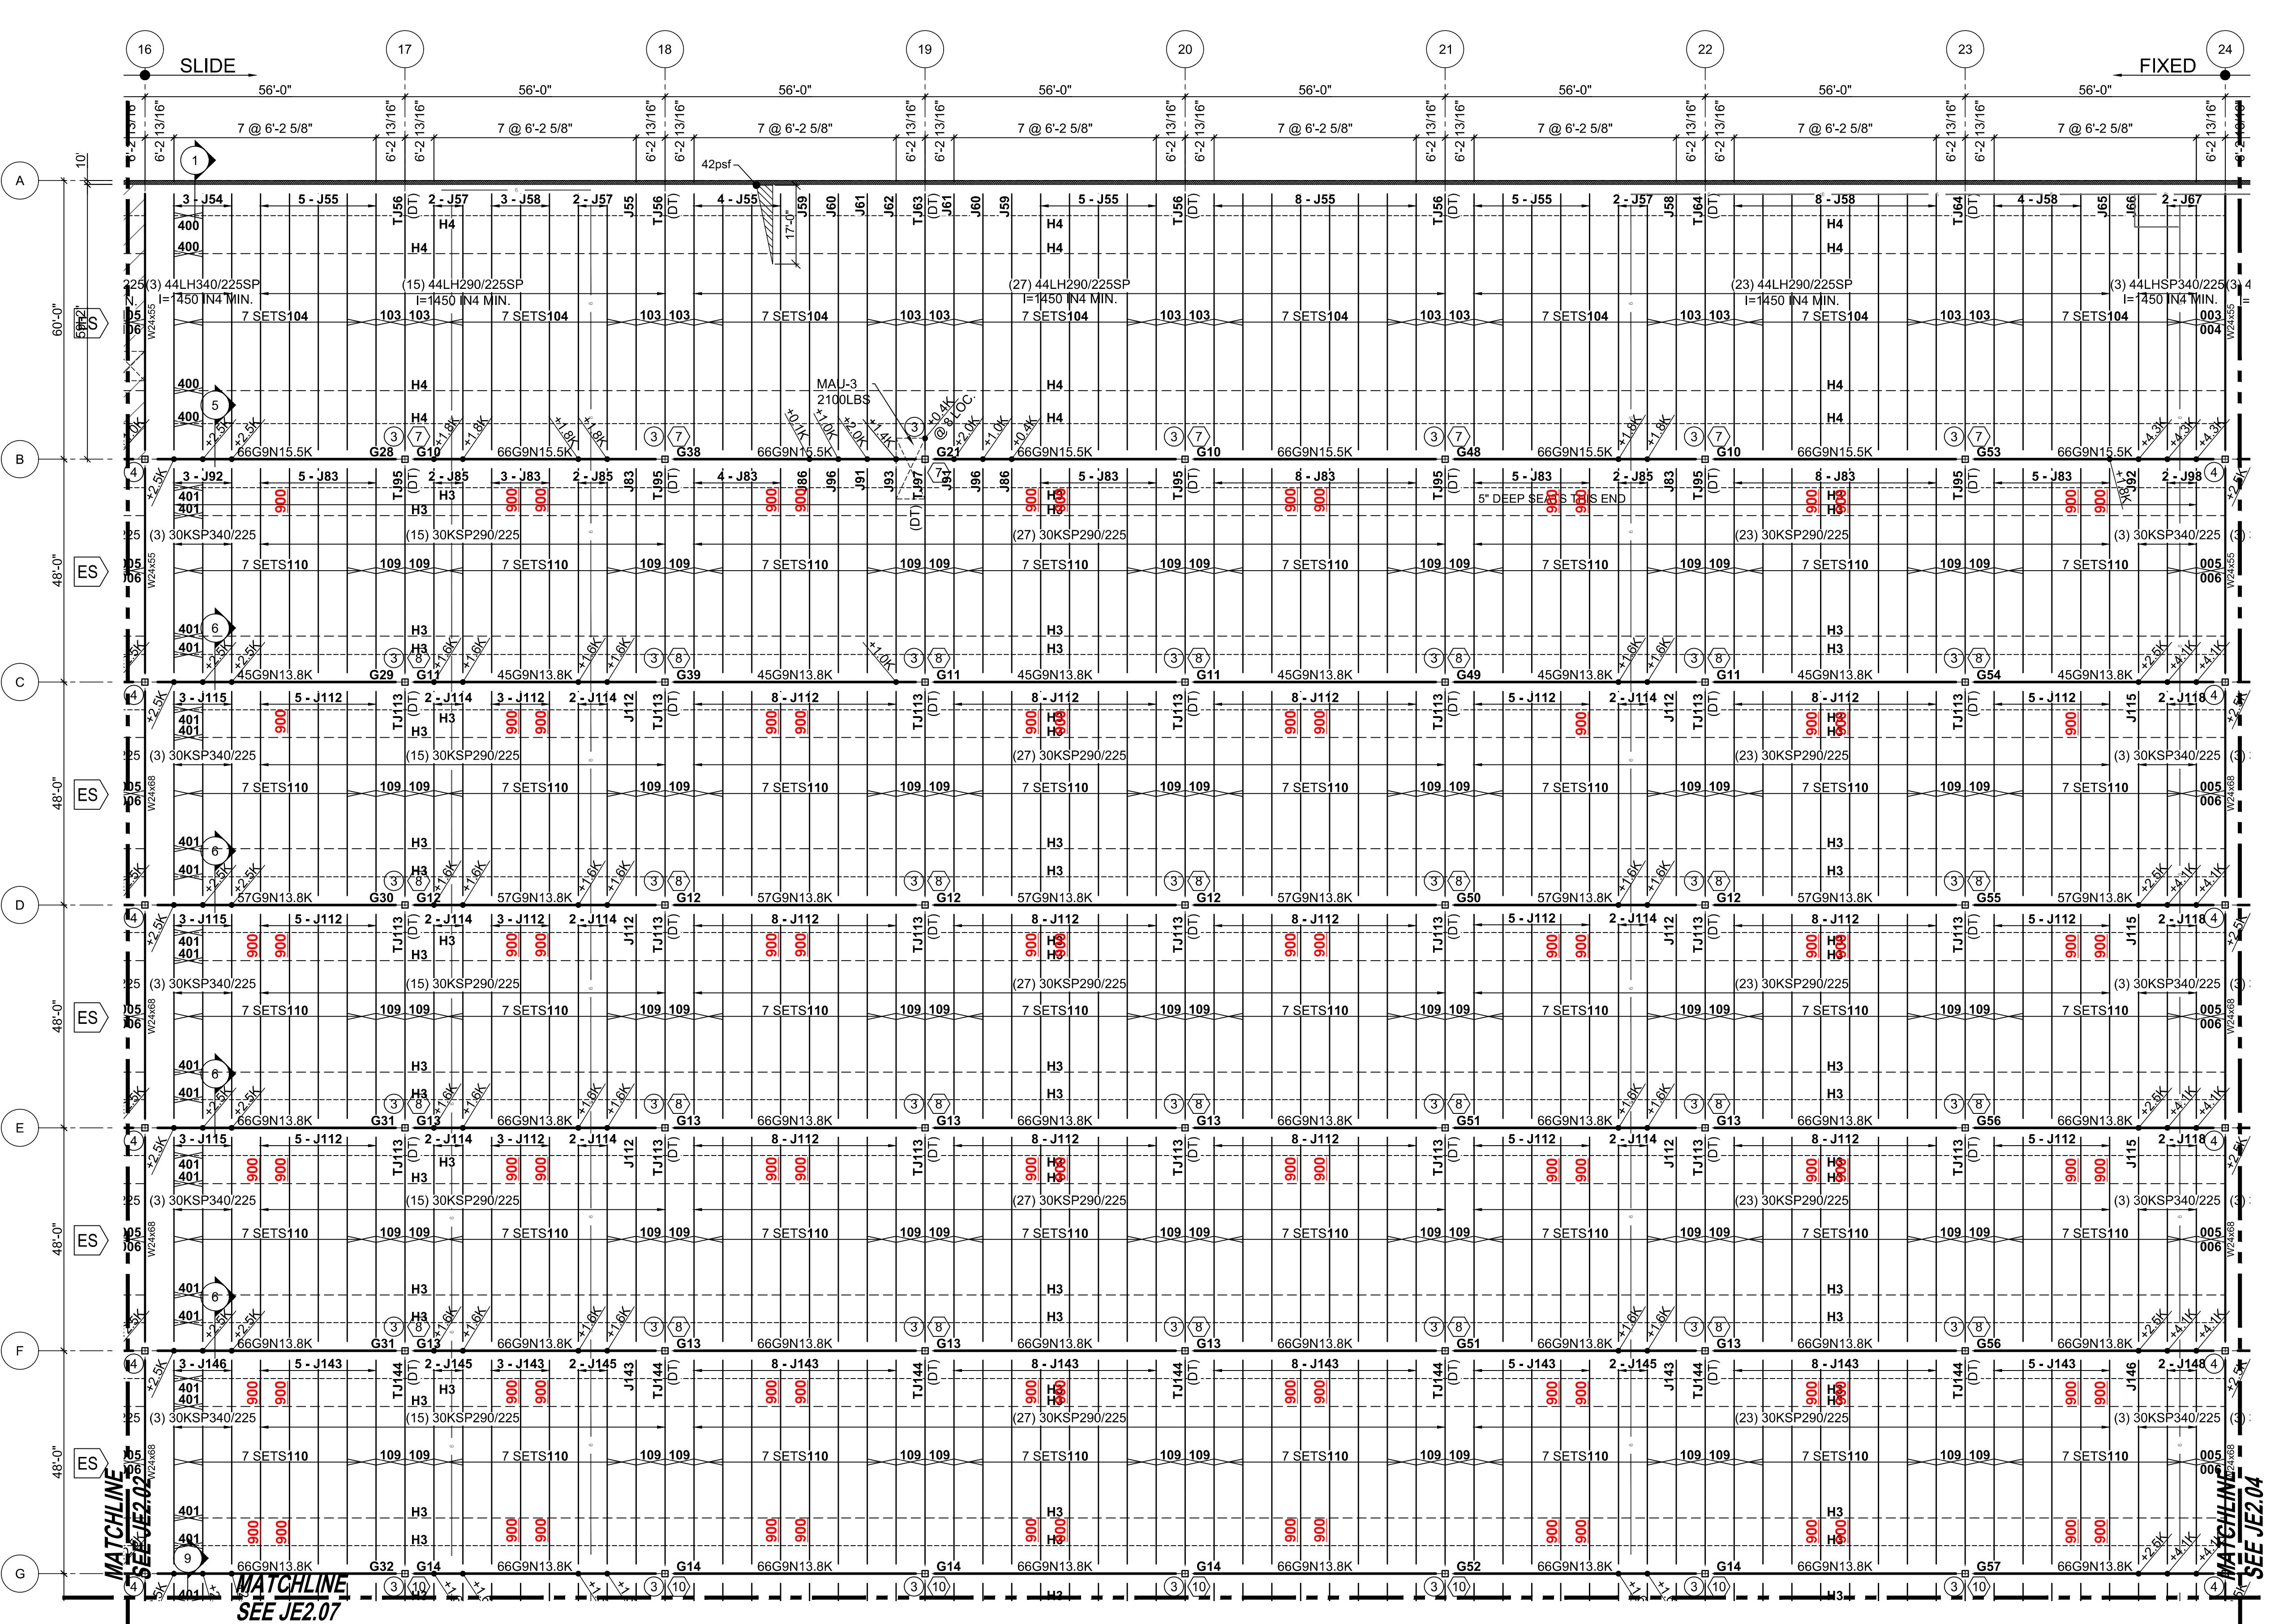

ROOF JOIST FRAMING PLAN 'C'
REF: S2.0C SEQ: SEE PLAN

1. REFERENCE DWG JE1.01 FOR LEGEND, SYMBOLS, & ABBREVIATIONS.
2. REFERENCE "TYPICAL JOIST REINFORCEMENT" DETAIL ON JOIST DRAWING JE1.01.
3. THE TAG END OF THE JOIST IS THE END AT WHICH THE PIECEMARK IS LOCATED.
4. FOR SECTIONS SEE DWG JE3.01.
5. ALL JOISTS WITH SPANS 40'-0" AND GREATER TO HAVE BOLTED CONNECTION.
6. ALL JOISTS AND JOIST GIRDER BEARING COL'S ARE HSS 12x12 UNO.
7. ○ DENOTES JOIST CONNECTION (SEE JOIST SECTIONS).
8. ○ DENOTES GIRDER CONNECTION (SEE JOIST SECTIONS).
9. 900 - 920 KNEE BRACE ONLY IF REQ'D BY DESIGN, SEE PLAN FOR LOCATIONS.
10. DESIGN JOIST SEATS FOR 3.25K ROLLOVER (1.0 WIND) & 2.0K (1.0 SEISMIC) @
GRIDLINES A & N.
11. □ INDICATES SNOW DRIFT.
12. ALL JOIST ENDS AND TOP CHORDS TO BE DESIGNED FOR AXIAL FORCE OF 4.0K (1.0
WIND) AND 7.5K (1.0 SEISMIC) FOR JOISTS BETWEEN LINE A & B AND M & N.


NET UPLIFT = SEE DIAGRAM
ON DWG JE3.03

ADDITIONAL BRIDGING DUE TO UPLIFT
SEE JE3.02 FOR JOIST/BRIDGING DIAGRAM

NOTE: Do not use APPROVAL drawings for joist and bridging erection.
ERECTOR NOTE: See Sheet JE2.03 for placement of bridging at top and bottom chords to avoid conflict with ESFR.
ERECTOR NOTE: Erector, locate bridging to meet fire marshal code clearances required for ESFR sprinkler system function. Bridging location tolerance is +or- 4'. Contact Canam if bridging locations shown on plans and/or proper clearances cannot be achieved.
SPRINKLER INSTALLER NOTE: ESFR feeder lines may require slight adjustment from plan dimensions to clear some confined joist web members. Check with Fire Protection designer for limits on amount of adjustment.
SPRINKLER MAIN INSTALLER NOTE: ALL sprinkler mains, 4" and larger, shall have connections to joists be hung concentrically achieved by loading thru the center of gravity of a single joist and/or by trapeze type hanger. Side mounting mains to a single joist is prohibited.

ES = ERECTION STABILITY BRIDGING
(MUST BE IN PLACE PRIOR TO
RELEASING HOISTING LINES.)

- — CONT. HORIZONTAL BRIDGING
TYP @ TOP AND BOTTOM CHORDS.
H3= L1 1/2x1 1/2x0.109
H4= L1 3/4x1 3/4x0.143
- — BOLTED-X BRIDGING
L1 1/4x1 1/4x0.109
- — 400 - 799
WELDED-X BRIDGING
L1 1/4x1 1/4x0.109
- - - - UPLIFT BRIDGING
TYP @ BOTTOM CHORD ONLY
H3= L1 1/2x1 1/2x0.109
H4= L1 3/4x1 3/4x0.143

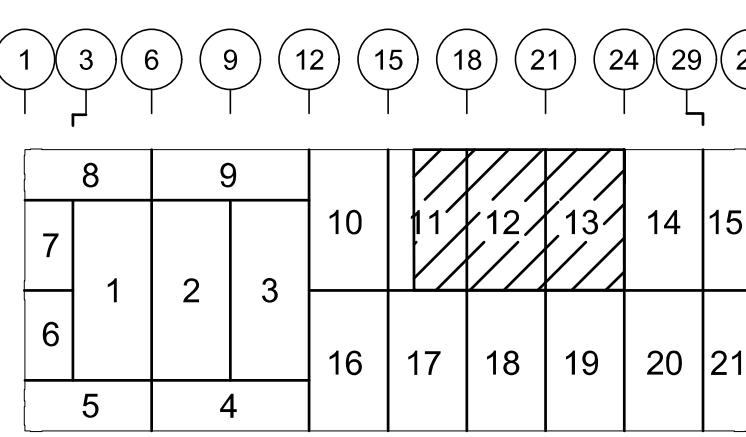


SEQUENCE PLAN

REVISION NO.	DATE	DESCRIPTION
--------------	------	-------------


**FOR APPROVAL ONLY
NOT FOR FIELD USE**

DATE SENT FOR FIELD USE:

DATE SENT FOR APPROVAL:

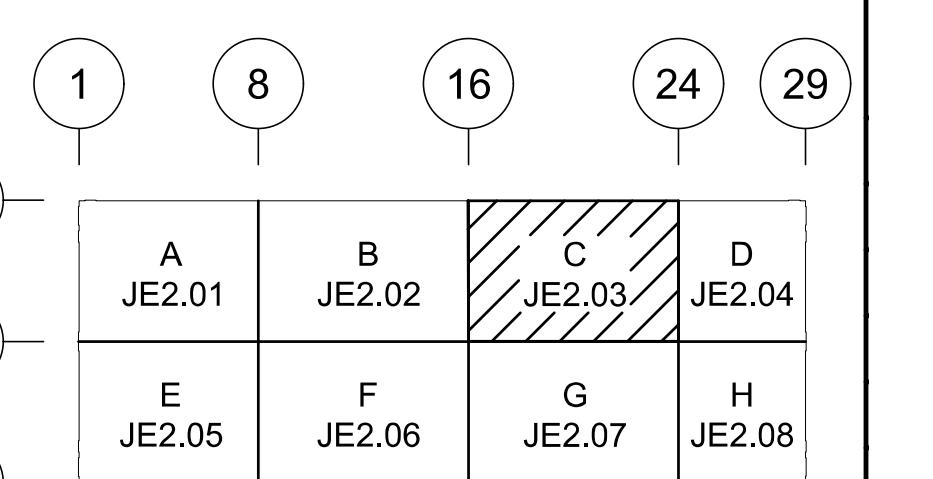

KEY PLAN

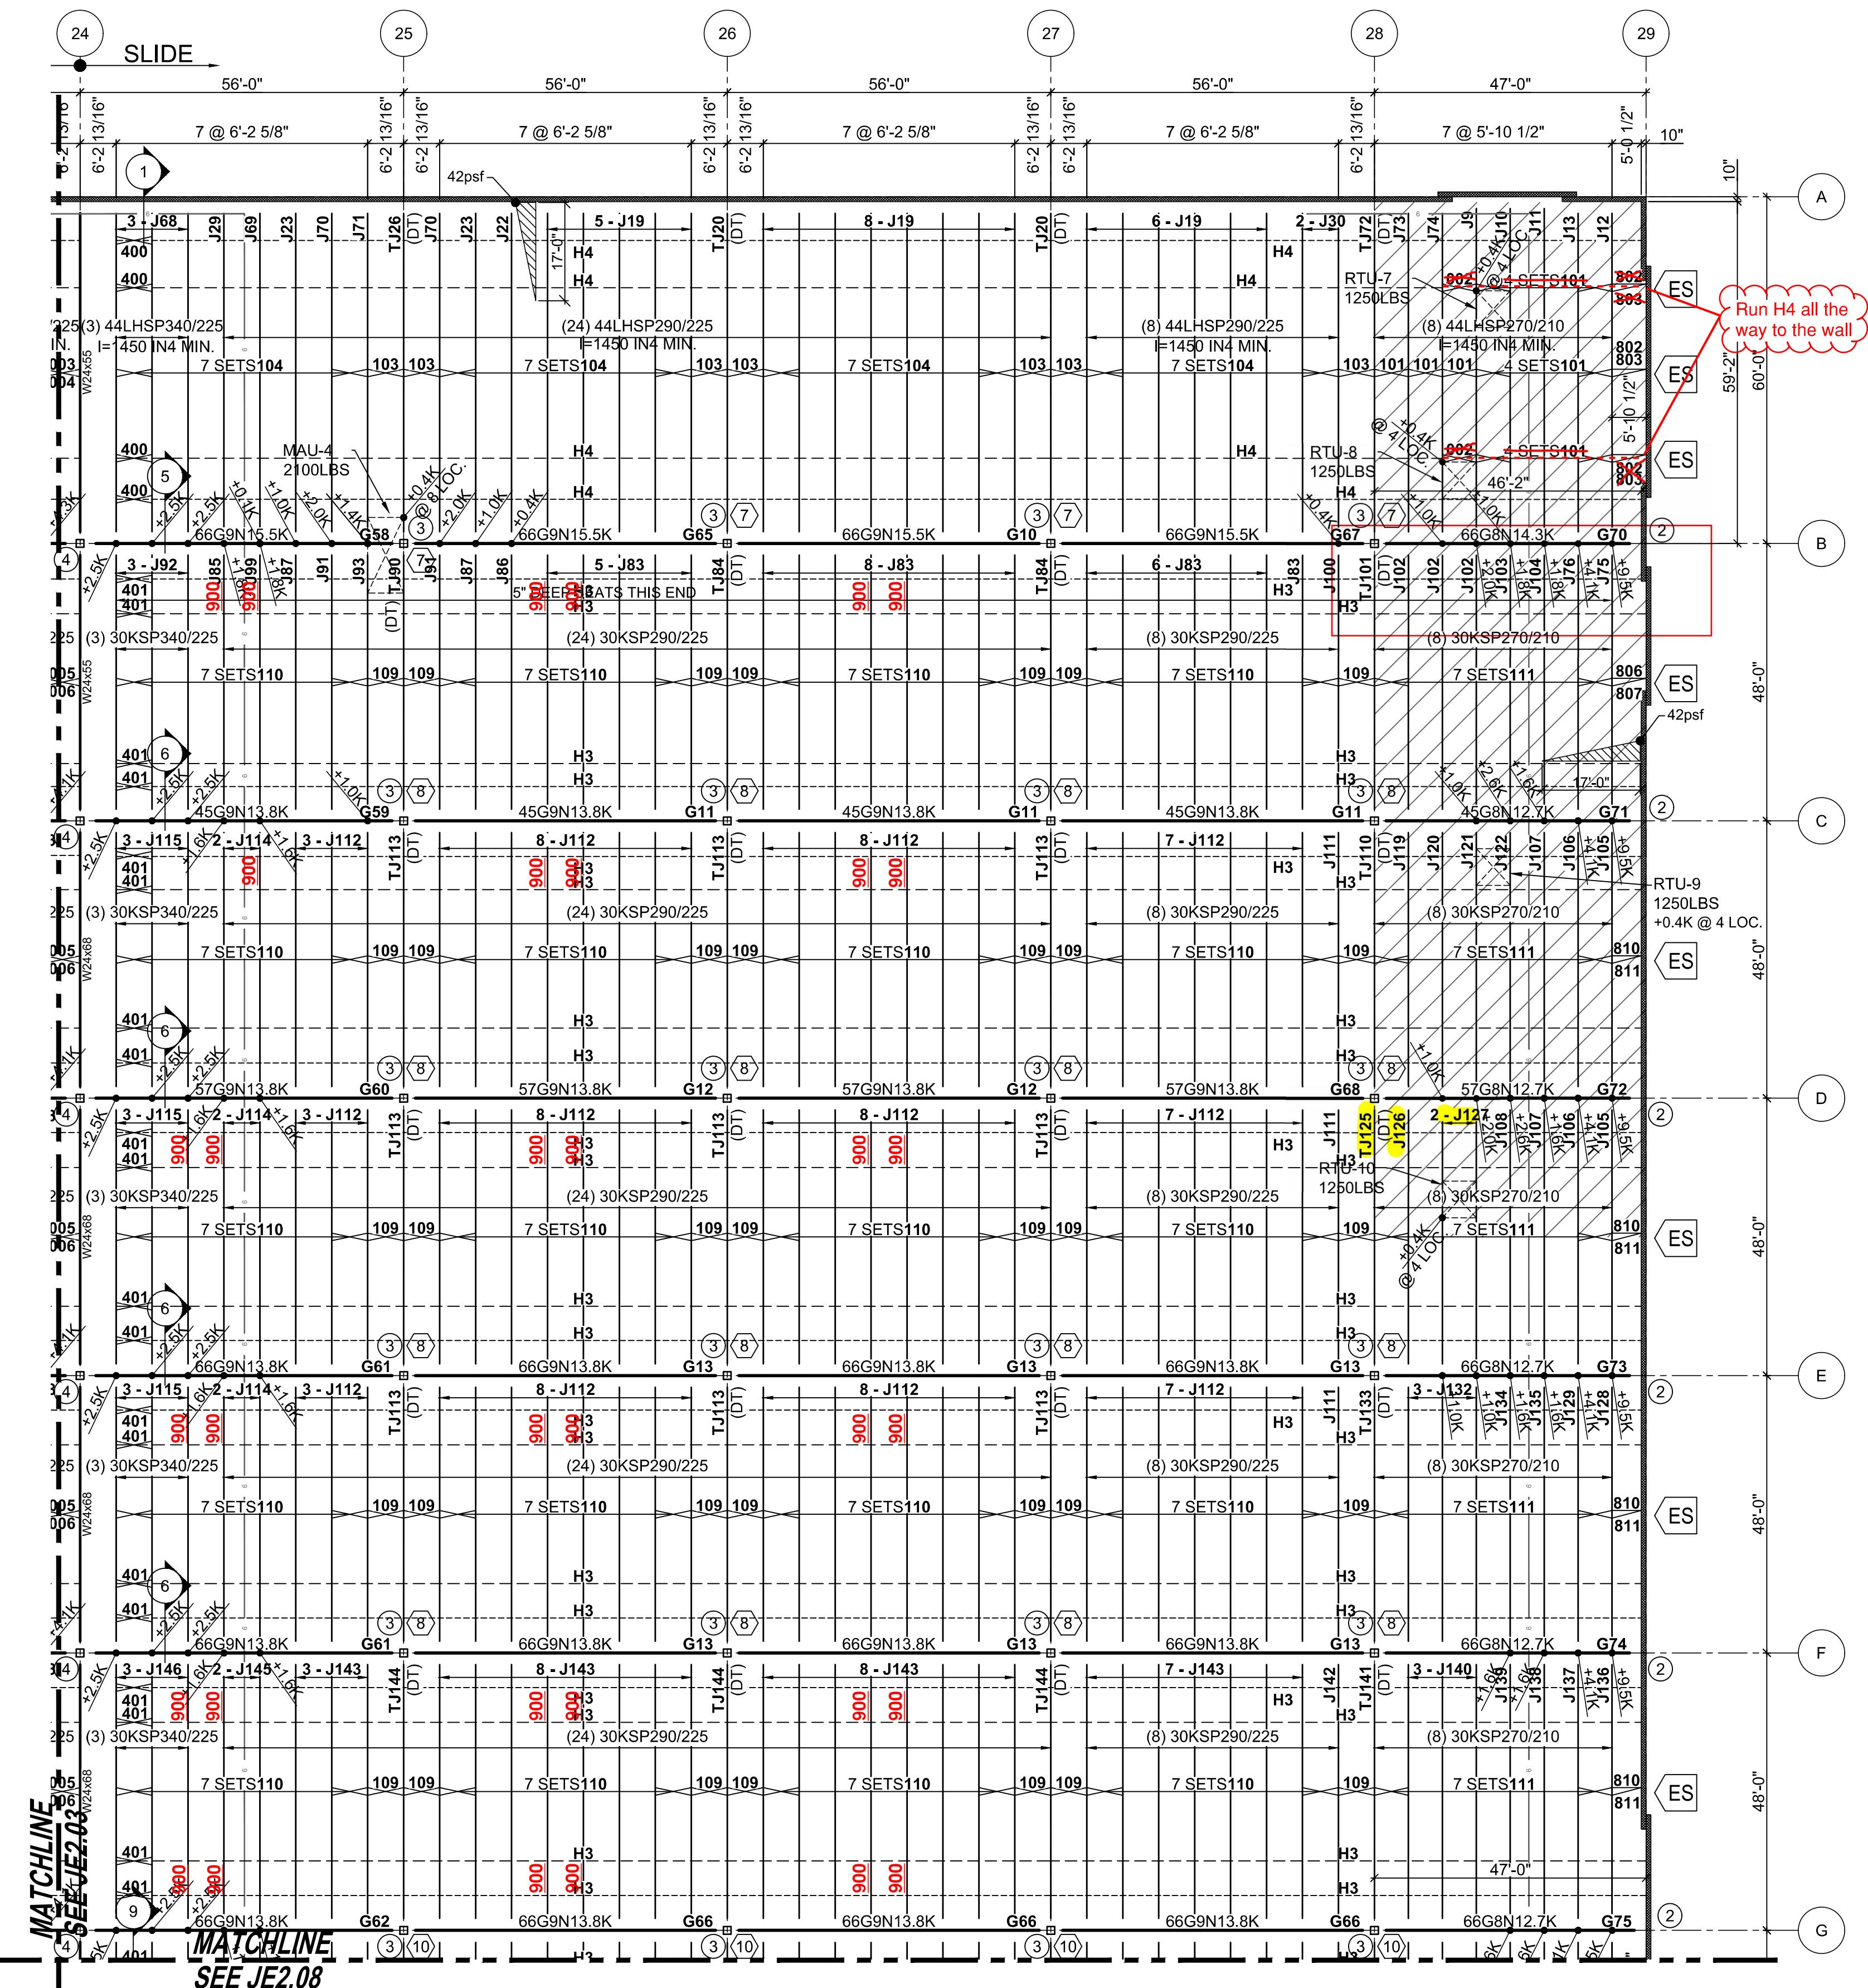

ROOF JOIST FRAMING PLAN '1'

REF: S2.20D


SEQ: SEE PLAN

1. REFERENCE DWG JE1.01 FOR LEGEND, SYMBOLS, & ABBREVIATIONS.
2. REFERENCE "TYPICAL JOIST REINFORCEMENT" DETAIL ON JOIST DRAWING JE1.01.
3. THE TAG END OF THE JOIST IS THE END AT WHICH THE PIECEMARK IS LOCATED.
4. FOR SECTIONS SEE DWG JE3.01
5. ALL JOISTS WITH SPANS 40'-0" AND GREATER TO HAVE BOLTED CONNECTION.
6. ALL JOISTS AND JOIST GIRDER BEARING COL'S ARE HSS 12x12 UNO.
7. DENOTES JOIST CONNECTION (SEE JOIST SECTIONS).
8. DENOTES GIRDER CONNECTION (SEE JOIST SECTIONS).
9. 900 - 920 KNEE BRACE ONLY IF REQ'D BY DESIGN, SEE PLAN FOR LOCATIONS.
10. DESIGN JOIST SEATS FOR 3.25K ROLLOVER (1.0 WIND) & 2.0K (1.0 SEISMIC) @ GRIDLINES A & N.
11. INDICATES SNOW DRIFT.
12. ALL JOIST ENDS AND TOP CHORDS TO BE DESIGNED FOR AXIAL FORCE OF 4.0K (1.0 WIND) AND 7.5K (1.0 SEISMIC) FOR JOISTS BETWEEN LINE A & B AND M & N.
13. LIMIT JOIST & GIRDER DEFLECTION TO L/240 UNDER LIVE OR SNOW LOAD AND L/360 AT OFFICE AREAS WHERE INDICATED ON PLAN.

NET UPLIFT = SEE DIAGRAM
ON DWG JE3.03

ADDITIONAL BRIDGING DUE TO UPLIFT
SEE JE3.02 FOR JOIST/BRIDGING DIAGRAM

ES = ERECTION STABILITY BRIDGING
(MUST BE IN PLACE PRIOR TO
RELEASING HOISTING LINES.)

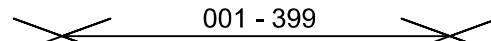- — — — — CONT. HORIZONTAL BRIDGING
TYP @ TOP AND BOTTOM CHORDS.
H3= L1 1 1/2x1 1/2x0.109
H4= L1 3/4x1 3/4x0.143
-  001 - 399
BOLTED-X BRIDGING
L1 1 1/4x1 1/4x0.109
-  400 - 799
WELDED-X BRIDGING
L1 1 1/4x1 1/4x0.109
- - - - - UPLIFT BRIDGING
TYP @ BOTTOM CHORD ONLY
H3= L1 1 1/2x1 1/2x0.109
H4= L1 3/4x1 3/4x0.143


NOTE: Do not use APPROVAL drawings for joist and bridging erection.

RECTOR NOTE: See Sheet JE2.03 for placement of bridging at top and bottom chords to avoid conflict with SFR.

RECTOR NOTE: Erector, locate bridging to meet fire marshal code clearances required for ESFR sprinkler system function. Bridging location tolerance is +or- 4". Contact Canam if bridging locations shown on plans and/or proper clearances cannot be achieved.

PRINKLER INSTALLER NOTE: ESFR feeder lines may require slight adjustment from plan dimensions to clear some confined joist web members. Check with Fire protection designer for limits on amount of adjustment.

PRINKLER MAIN INSTALLER NOTE: ALL sprinkler mains, 4" and larger, shall have connections to joists being concentrically achieved by loading thru the center of gravity of a single joist and/or by trapeze type hanger. Sideounting mains to a single joist is prohibited.

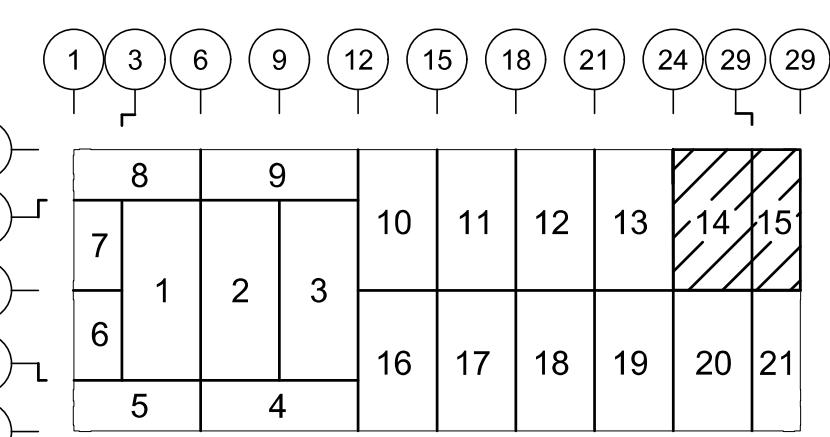


SEQUENCE PLAN

FOR APPROVAL ONLY


NOT FOR FIELD USE

SENT FOR FIELD USE

SENT FOR FIELD USE:

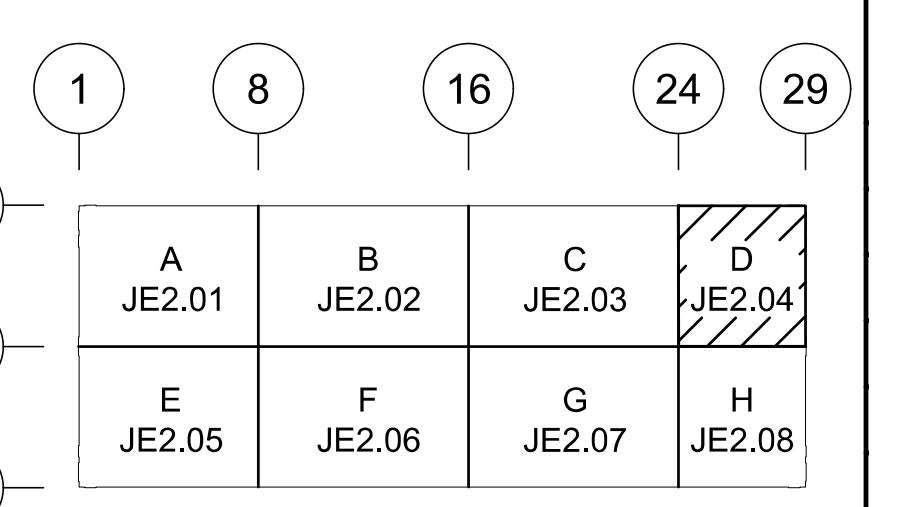

KEY PLAN

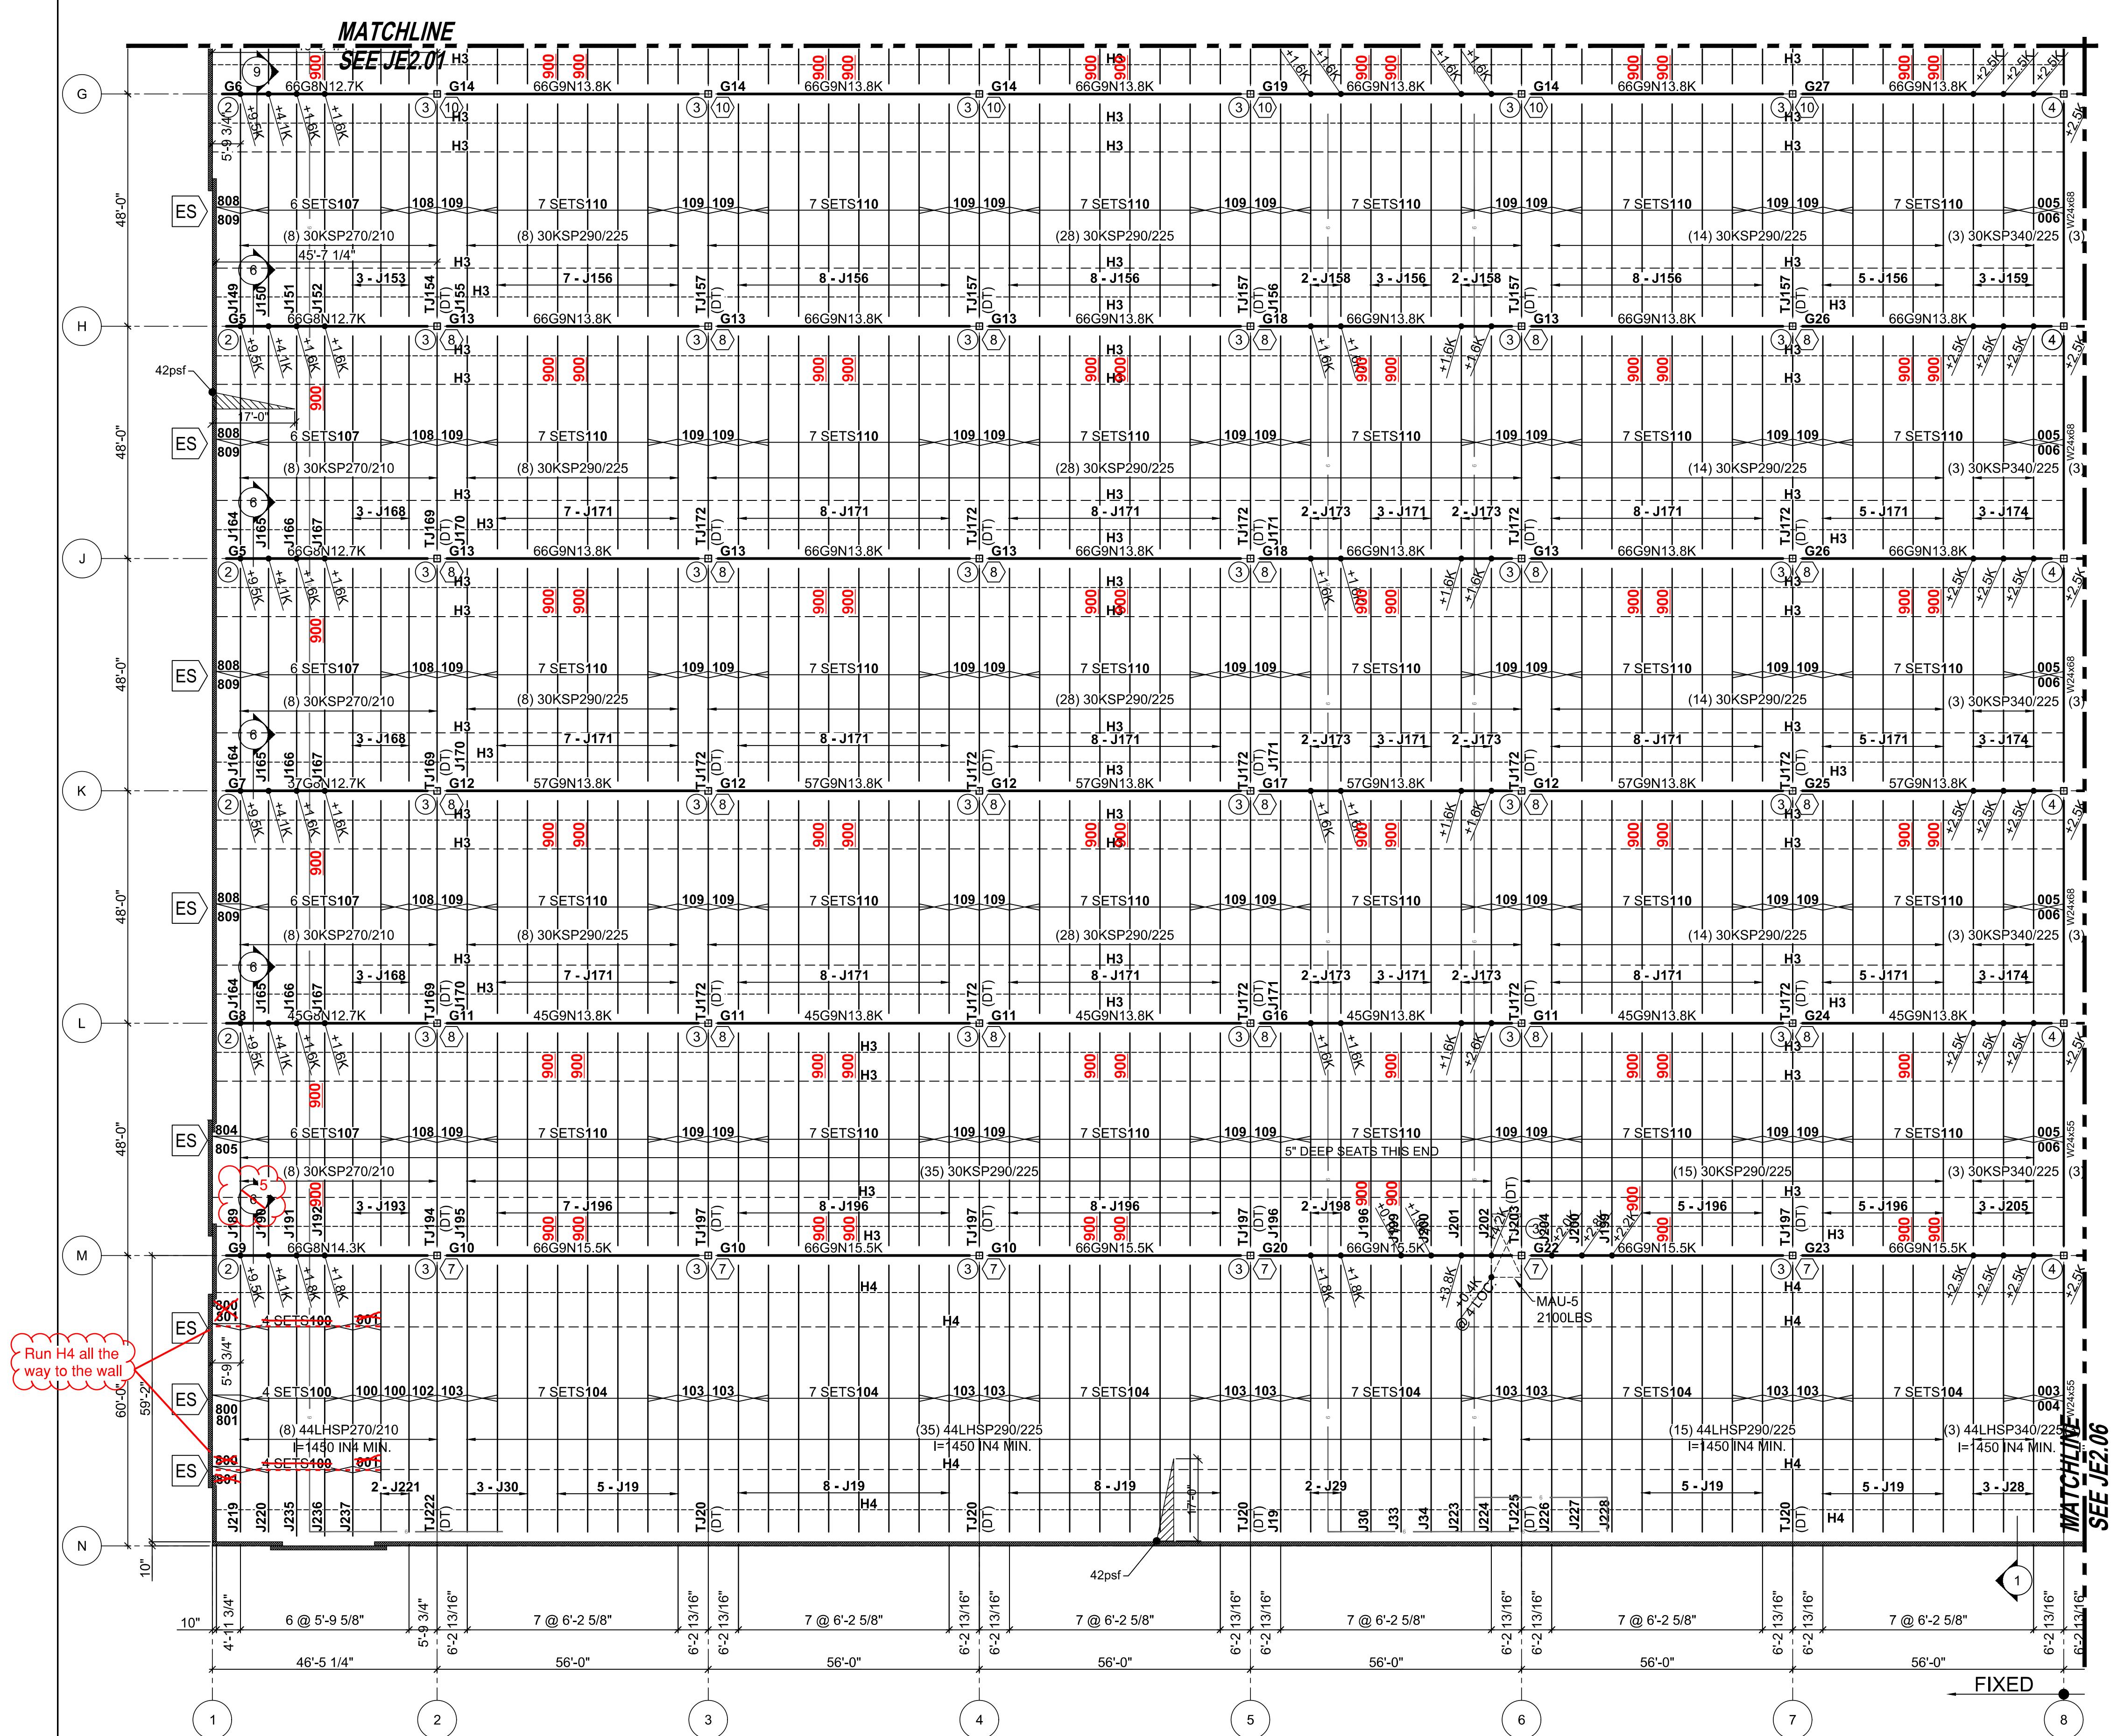

NOTE: Do not use APPROVAL drawings for joist and bridging erection.

ERECTOR NOTE: See Sheet JE2.03 for placement of bridging at top and bottom chords to avoid conflict with ESFR.


ERECTOR NOTE: Erector, locate bridging to meet fire marshal code clearances required for ESFR sprinkler system function. Bridging location tolerance is +or- 4". Contact Canam if bridging locations shown on plans and/or proper clearances cannot be achieved.

SPRINKLER INSTALLER NOTE: ESFR feeder lines may require slight adjustment from plan dimensions to clear some confined joist web members. Check with Fire Protection designer for limits on amount of adjustment.

SPRINKLER MAIN INSTALLER NOTE: ALL sprinkler mains, 4" and larger, shall have connections to joists be hung concentrically achieved by loading thru the center of gravity of a single joist and/or by trapeze type hanger. Side mounting mains to a single joist is prohibited.

ES = ERECTION STABILITY BRIDGING
(MUST BE IN PLACE PRIOR TO
RELEASING HOISTING LINES.)

- — CONT. HORIZONTAL BRIDGING
TYP @ TOP AND BOTTOM CHORDS.
H3= L1 1/2x1 1/2x0.109
H4= L1 3/4x1 3/4x0.143
- — 001 - 399
- — 400 - 799
- — UPLIFT BRIDGING
TYP @ BOTTOM CHORD ONLY
H3= L1 1/2x1 1/2x0.109
H4= L1 3/4x1 3/4x0.143

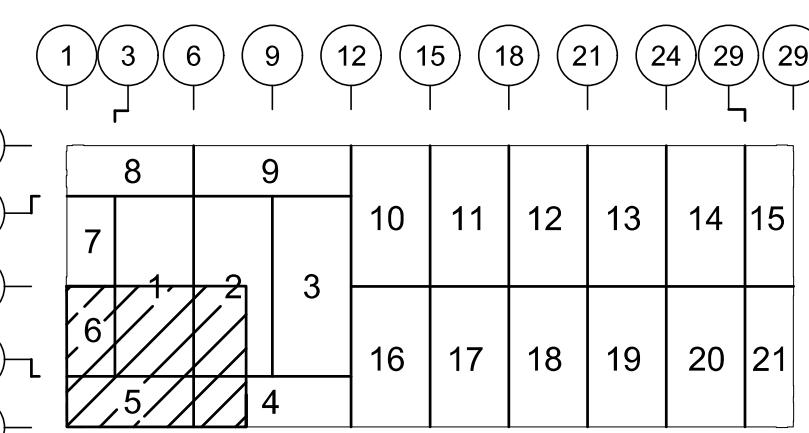

SEQUENCE PLAN

REVISION NO.	DATE	DESCRIPTION

**FOR APPROVAL ONLY
NOT FOR FIELD USE**

DATE SENT FOR FIELD USE:
DATE SENT FOR APPROVAL:

ROOF JOIST FRAMING PLAN 'E'

REF: S2.20E SEQ: SEE PLAN


1. REFERENCE DWG JE1.01 FOR LEGEND, SYMBOLS, & ABBREVIATIONS.
2. REFERENCE 'TYPICAL JOIST REINFORCEMENT' DETAIL ON JOIST DRAWING JE1.01.
3. THE TAG END OF THE JOIST IS THE END AT WHICH THE PIECEMARK IS LOCATED.
4. FOR SECTIONS SEE DWG JE3.01.
5. ALL JOISTS WITH SPANS 40'-0" AND GREATER TO HAVE BOLTED CONNECTION.
6. ALL JOISTS AND JOIST GIRDERS BEARING COL'S ARE HSS 12x12 UNO.
7. DENOTES JOIST CONNECTION (SEE JOIST SECTIONS).
8. DENOTES GIRDERS CONNECTION (SEE JOIST SECTIONS).
9. 900 - 920 KNEE BRACE ONLY IF REQ'D BY DESIGN, SEE PLAN FOR LOCATIONS.
10. DESIGN JOIST SEATS FOR 3.25K ROLLOVER (1.0 WIND) & 2.0K (1.0 SEISMIC) @ GRIDLINES A & N.
11. INDICATES SNOW DRIFT.
12. ALL JOIST ENDS AND TOP CHORDS TO BE DESIGNED FOR AXIAL FORCE OF 4.0K (1.0 WIND) AND 7.5K (1.0 SEISMIC) FOR JOISTS BETWEEN LINE A & B AND M & N.

NET UPLIFT = SEE DIAGRAM
ON DWG JE3.03

ADDITIONAL BRIDGING DUE TO UPLIFT
SEE JE3.02 FOR JOIST/BRIDGING DIAGRAM

1	8	16	24	29
A	JE2.01	B	JE2.02	C
G	JE2.05	F	JE2.06	G
N				JE2.07
				JE2.08

KEY PLAN

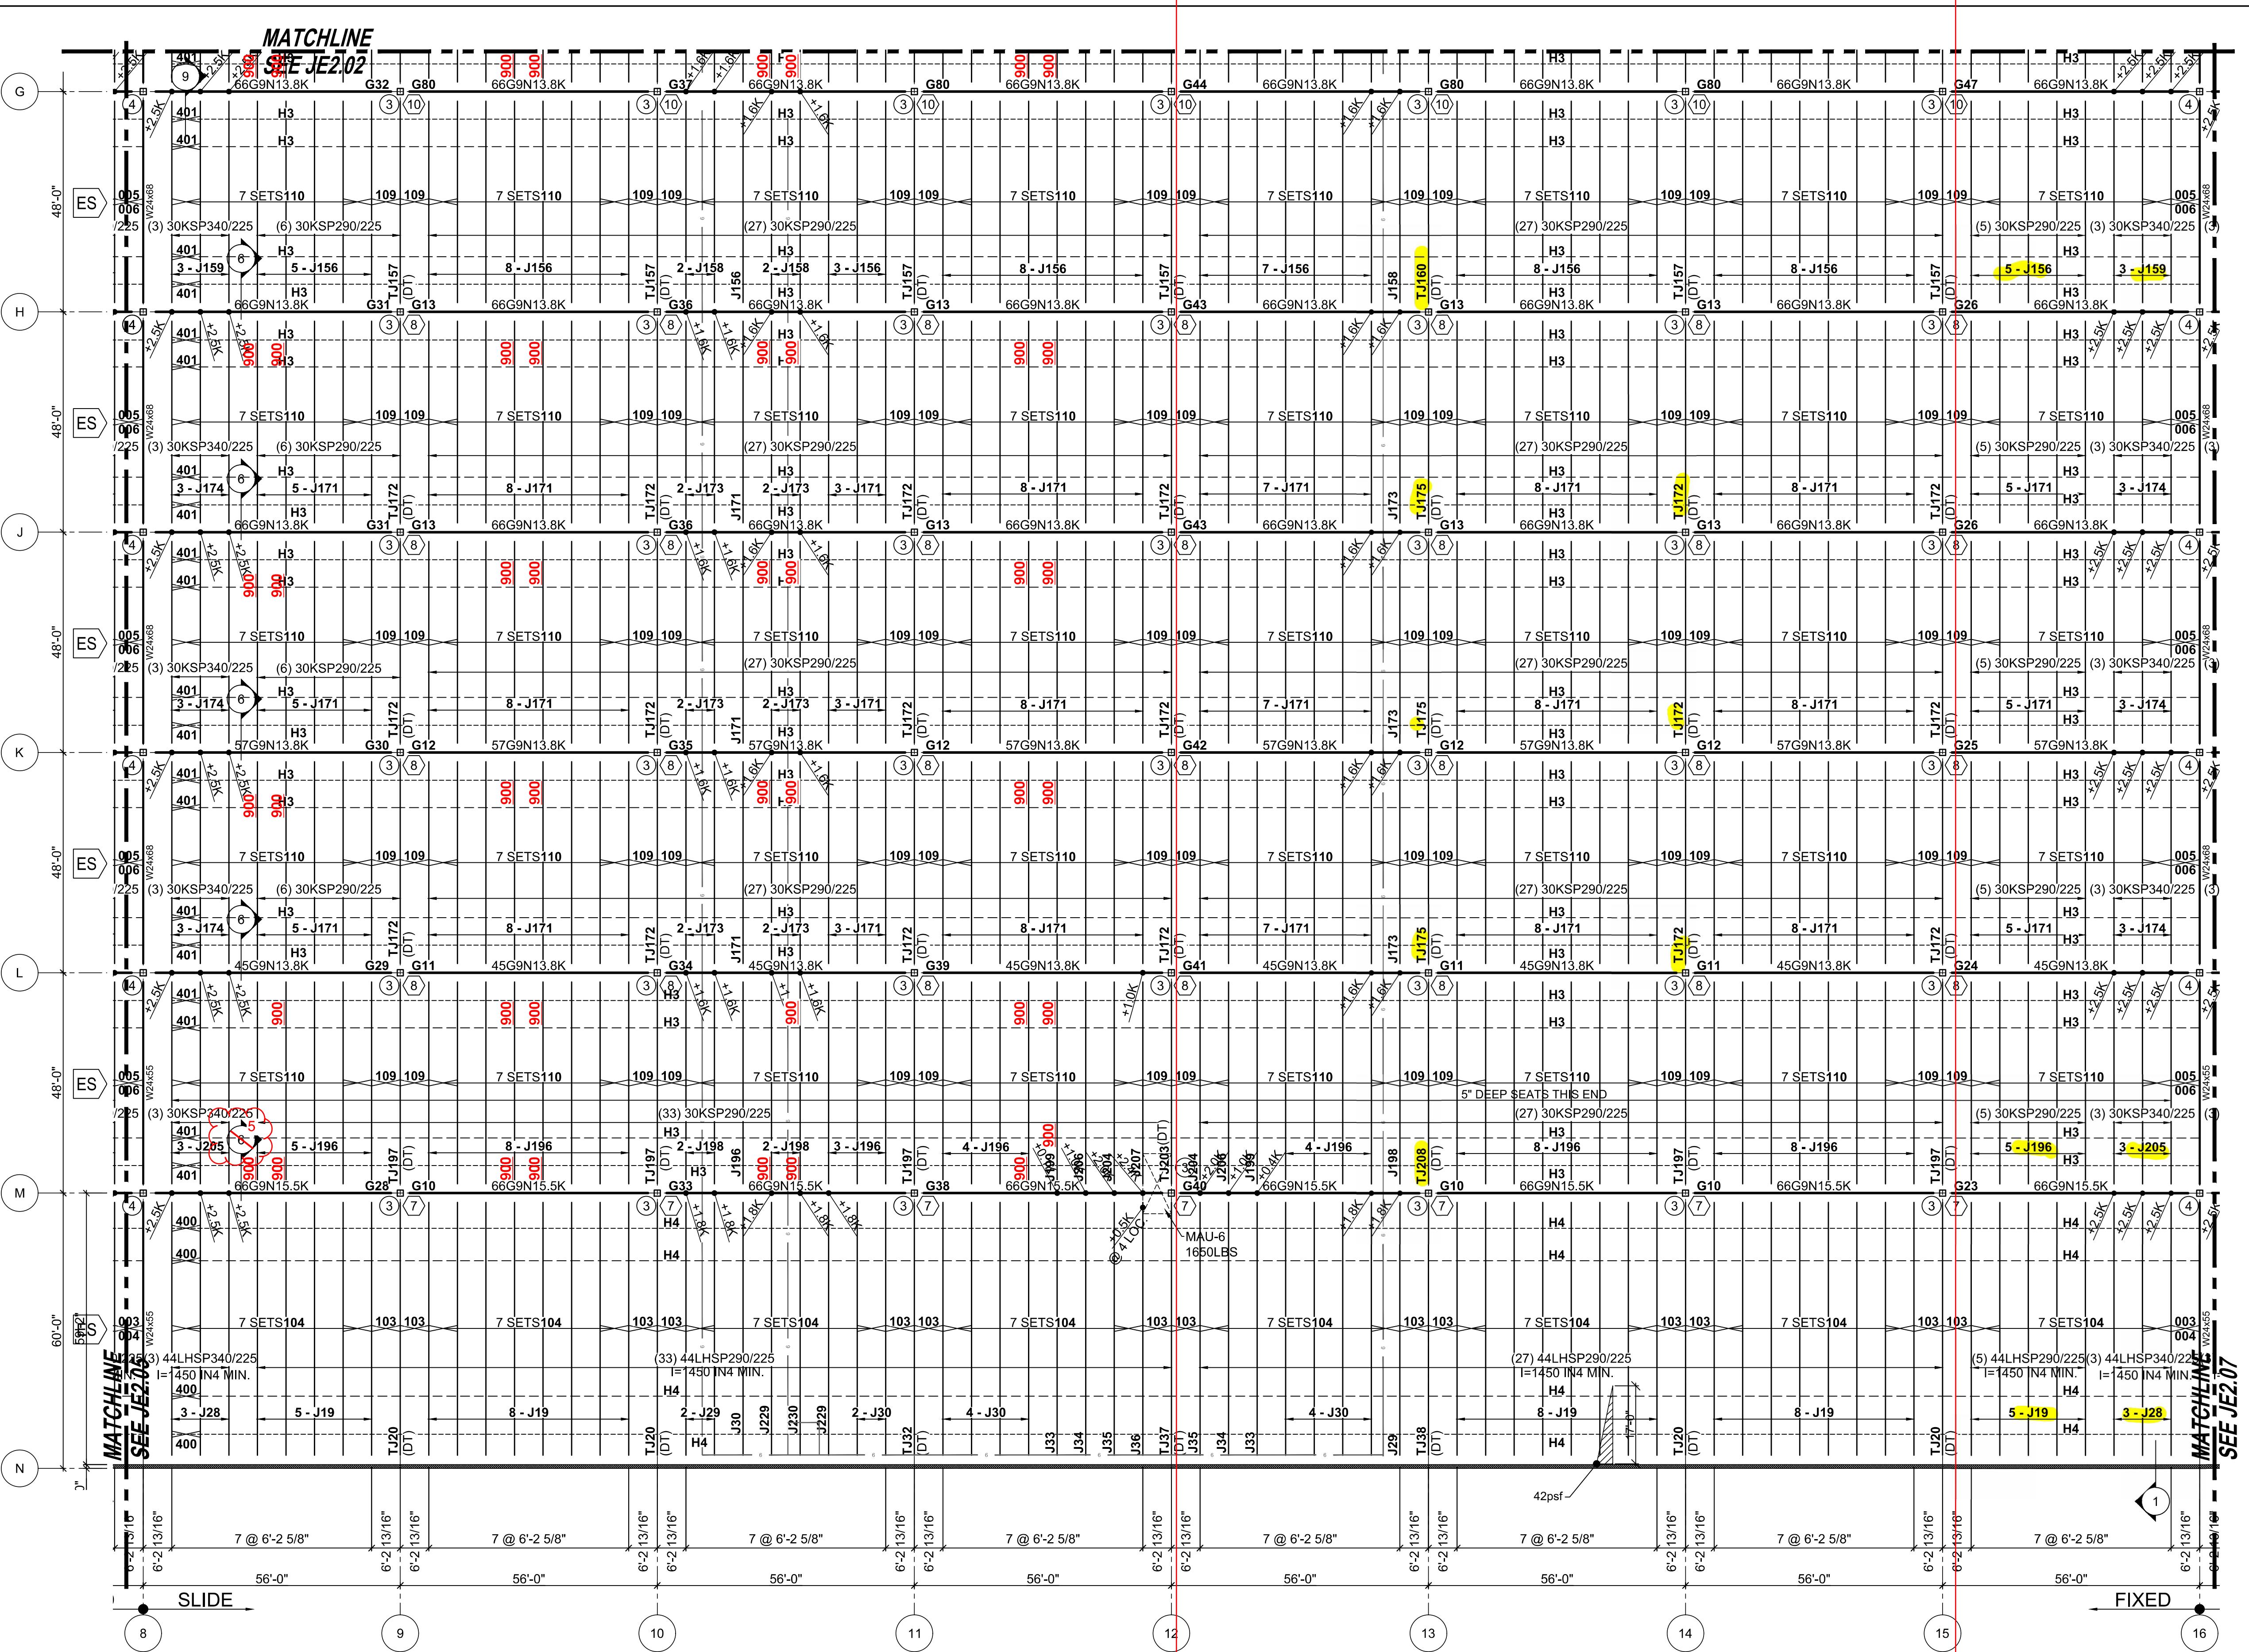

NOTE: Do not use APPROVAL drawings for joist and bridging erection.

ERECTOR NOTE: See Sheet JE2.03 for placement of bridging at top and bottom chords to avoid conflict with ESFR.


ERECTOR NOTE: Erector, locate bridging to meet fire marshal code clearances required for ESFR sprinkler system function. Bridging location tolerance is +or- 4". Contact Canam if bridging locations shown on plans and/or proper clearances cannot be achieved.

SPRINKLER INSTALLER NOTE: ESFR feeder lines may require slight adjustment from plan dimensions to clear some confined joist web members. Check with Fire Protection designer for limits on amount of adjustment.

SPRINKLER MAIN INSTALLER NOTE: ALL sprinkler mains, 4" and larger, shall have connections to joists be hung concentrically achieved by loading thru the center of gravity of a single joist and/or by trapeze type hanger. Side mounting mains to a single joist is prohibited.

ES = ERECTION STABILITY BRIDGING
(MUST BE IN PLACE PRIOR TO
RELEASING HOISTING LINES.)

- — CONT. HORIZONTAL BRIDGING
TYP @ TOP AND BOTTOM CHORDS.
H3= L1 1/2x1 1/2x0.109
H4= L1 3/4x1 3/4x0.143
- — 001 - 399
- — BOLTED-X BRIDGING
L1 1/4x1 1/4x0.109
- — 400 - 799
- — WELDED-X BRIDGING
L1 1/4x1 1/4x0.109
- — UPLIFT BRIDGING
TYP @ BOTTOM CHORD ONLY
H3= L1 1/2x1 1/2x0.109
H4= L1 3/4x1 3/4x0.143

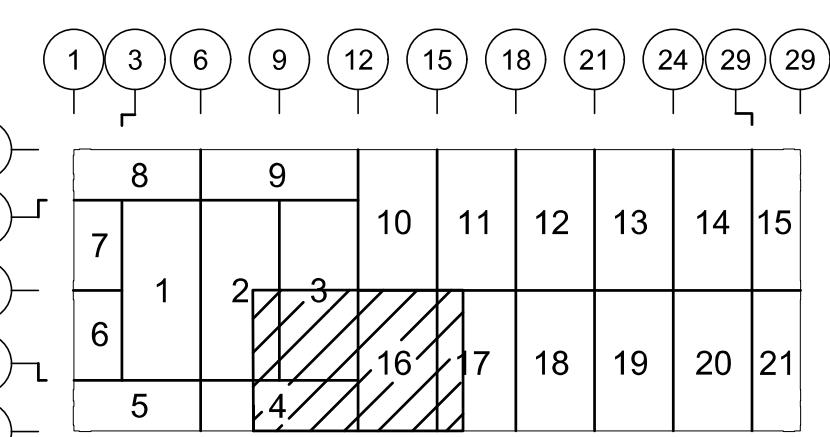

SEQUENCE PLAN

REVISION NO.	DATE	DESCRIPTION

**FOR APPROVAL ONLY
NOT FOR FIELD USE**

DATE SENT FOR FIELD USE:

DATE SENT FOR APPROVAL:

ROOF JOIST FRAMING PLAN 'F' REF: S2.20F SEQ: SEE PLAN

1. REFERENCE DWG JE1.01 FOR LEGEND, SYMBOLS & ABBREVIATIONS.
2. REFERENCE "PIECE JOIST REINFORCEMENT" DETAIL ON JOIST DRAWING JE1.01.
3. END OF THE JOIST AT THE END AT WHICH THE PIECE MARK IS LOCATED.
4. FOR SECTIONS SEE DWG JE3.01.
5. ALL JOISTS WITH SPANS 40'-0" AND GREATER TO HAVE BOLTED CONNECTION.
6. ALL JOISTS AND JOIST GIRDERS BEARING COL'S ARE HSS 12x12 UNO.
7. ○ DENOTES JOIST CONNECTION (SEE JOIST SECTIONS).
8. □ DENOTES GIRDERS CONNECTION (SEE JOIST SECTIONS).
9. 300-320 KNEE BRACE ONLY IF REQ'D BY DESIGN. SEE PLAN FOR LOCATIONS.
10. DESIGN JOIST SEATS FOR 3.25K ROLLOVER (1.0 WIND) & 2.0K (1.0 SEISMIC) @ GRIDLINES A & N.
11. □ INDICATES SNOW DRIFT.
12. ALL JOIST ENDS AND TOP CHORDS TO BE DESIGNED FOR AXIAL FORCE OF 4.0K (1.0 WIND) AND 7.5K (1.0 SEISMIC) FOR JOISTS BETWEEN LINE A & B AND M & N.

NET UPLIFT = SEE DIAGRAM
ON DWG JE3.03

ADDITIONAL BRIDGING DUE TO UPLIFT
SEE JE3.02 FOR JOIST/BRIDGING DIAGRAM

KEY PLAN

1	8	16	24	29
A	A JE2.01	B JE2.02	C JE2.03	D JE2.04
G	E JE2.05	F JE2.06	G JE2.07	H JE2.08

**OTE: Do not use APPROVAL drawings for joist and
ridging erection.**

RECTOR NOTE: See Sheet JE2.03 for placement of
ridging at top and bottom chords to avoid conflict with
SFR.

RECTOR NOTE: Erector, locate bridging to meet fire marshal code clearances required for ESFR sprinkler system function. Bridging location tolerance is +or- 4". Contact Canam if bridging locations shown on plans and/or proper clearances cannot be achieved.

PRINKLER INSTALLER NOTE: ESFR feeder lines may require slight adjustment from plan dimensions to clear some confined joist web members. Check with Fire protection designer for limits on amount of adjustment.


PRINKLER MAIN INSTALLER NOTE: ALL sprinkler mains, 4" and larger, shall have connections to joists being concentrically achieved by loading thru the center of gravity of a single joist and/or by trapeze type hanger. Sideounting mains to a single joist is prohibited.

ES = ERECTION STABILITY BRIDGING
(MUST BE IN PLACE PRIOR TO
RELEASING HOISTING LINES.)

— — — — — CONT. HORIZONTAL BRIDGING

TYP @ TOP AND BOTTOM CHORDS


H3= L1 1/2x1 1/2x0.109
 H4= L1 3/4x1 3/4x0.143

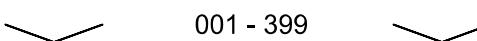

001 - 399

BOLTED-X BRIDGING

L1 1/4x1 1/4x0.109

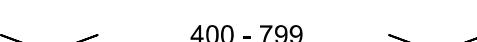

400 - 799

WELDED-X BRIDGING


L1 1/4x1 1/4x0.109



— — — — — UPLIFT BRIDGING

TYP @ BOTTOM CHORD ONLY

H3= L1 1/2x1 1/2x0.109
 H4= L1 3/4x1 3/4x0.143

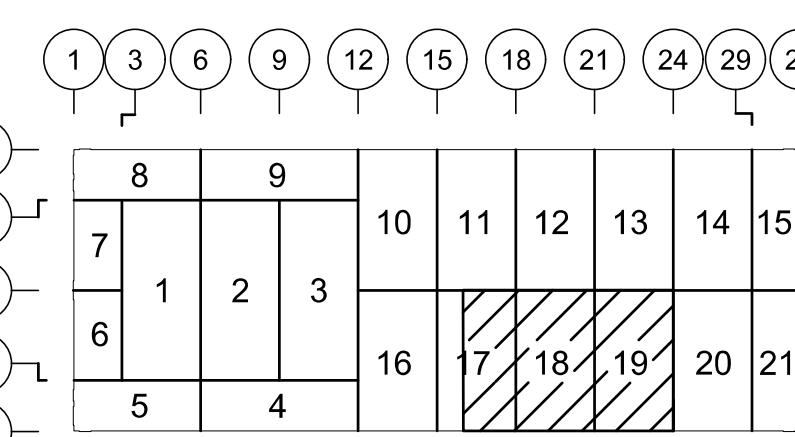

SEQUENCE PLAN

FOR APPROVAL ONLY

NOT FOR FIELD USE

MENT FOR FIELD USE

ENT FOR APPROVAL:

ROOF JOIST FRAMING PLAN 'G'

REF: S2.20G SEQ: SEE PLAN


1. REFERENCE DWG JE1.01 FOR LEGEND, SYMBOLS, & ABBREVIATIONS.
2. REFERENCE "TYPICAL JOIST REINFORCEMENT" DETAIL ON JOIST DRAWING JE1.01
3. THE TAG END OF THE JOIST IS THE END AT WHICH THE PIECEMARK IS LOCATED.
4. FOR SECTIONS SEE DWG JE3.01
5. ALL JOISTS WITH SPANS 40'-0" AND GREATER TO HAVE BOLTED CONNECTION.
6. ALL JOISTS AND JOIST GIRDER BEARING COL'S ARE HSS 12x12 UNO.
7. DENOTES JOIST CONNECTION (SEE JOIST SECTIONS).
8. DENOTES GIRDER CONNECTION (SEE JOIST SECTIONS).
9. ~~900 - 920~~ KNEE BRACE ONLY IF REQ'D BY DESIGN, SEE PLAN FOR LOCATIONS.
10. DESIGN JOIST SEATS FOR 3.25K ROLLOVER (1.0 WIND) & 2.0K (1.0 SEISMIC) @ GRIDLINES A & N.
11. INDICATES SNOW DRIFT.
12. ALL JOIST ENDS AND TOP CHORDS TO BE DESIGNED FOR AXIAL FORCE OF 4.0K WIND) AND 7.5K (1.0 SEISMIC) FOR JOISTS BETWEEN LINE A & B AND M & N.

NET UPLIFT = SEE DIAGRAM
ON DWG JE3.03

ADDITIONAL BRIDGING DUE TO UPL
SEE JE3.02 FOR JOIST/BRIDGING DIAGRAM

KEY PLAN

1	8	16	24	29
A JE2.01	B JE2.02	C JE2.03	D JE2.04	
E JE2.05	F JE2.06	G JE2.07	H JE2.08	

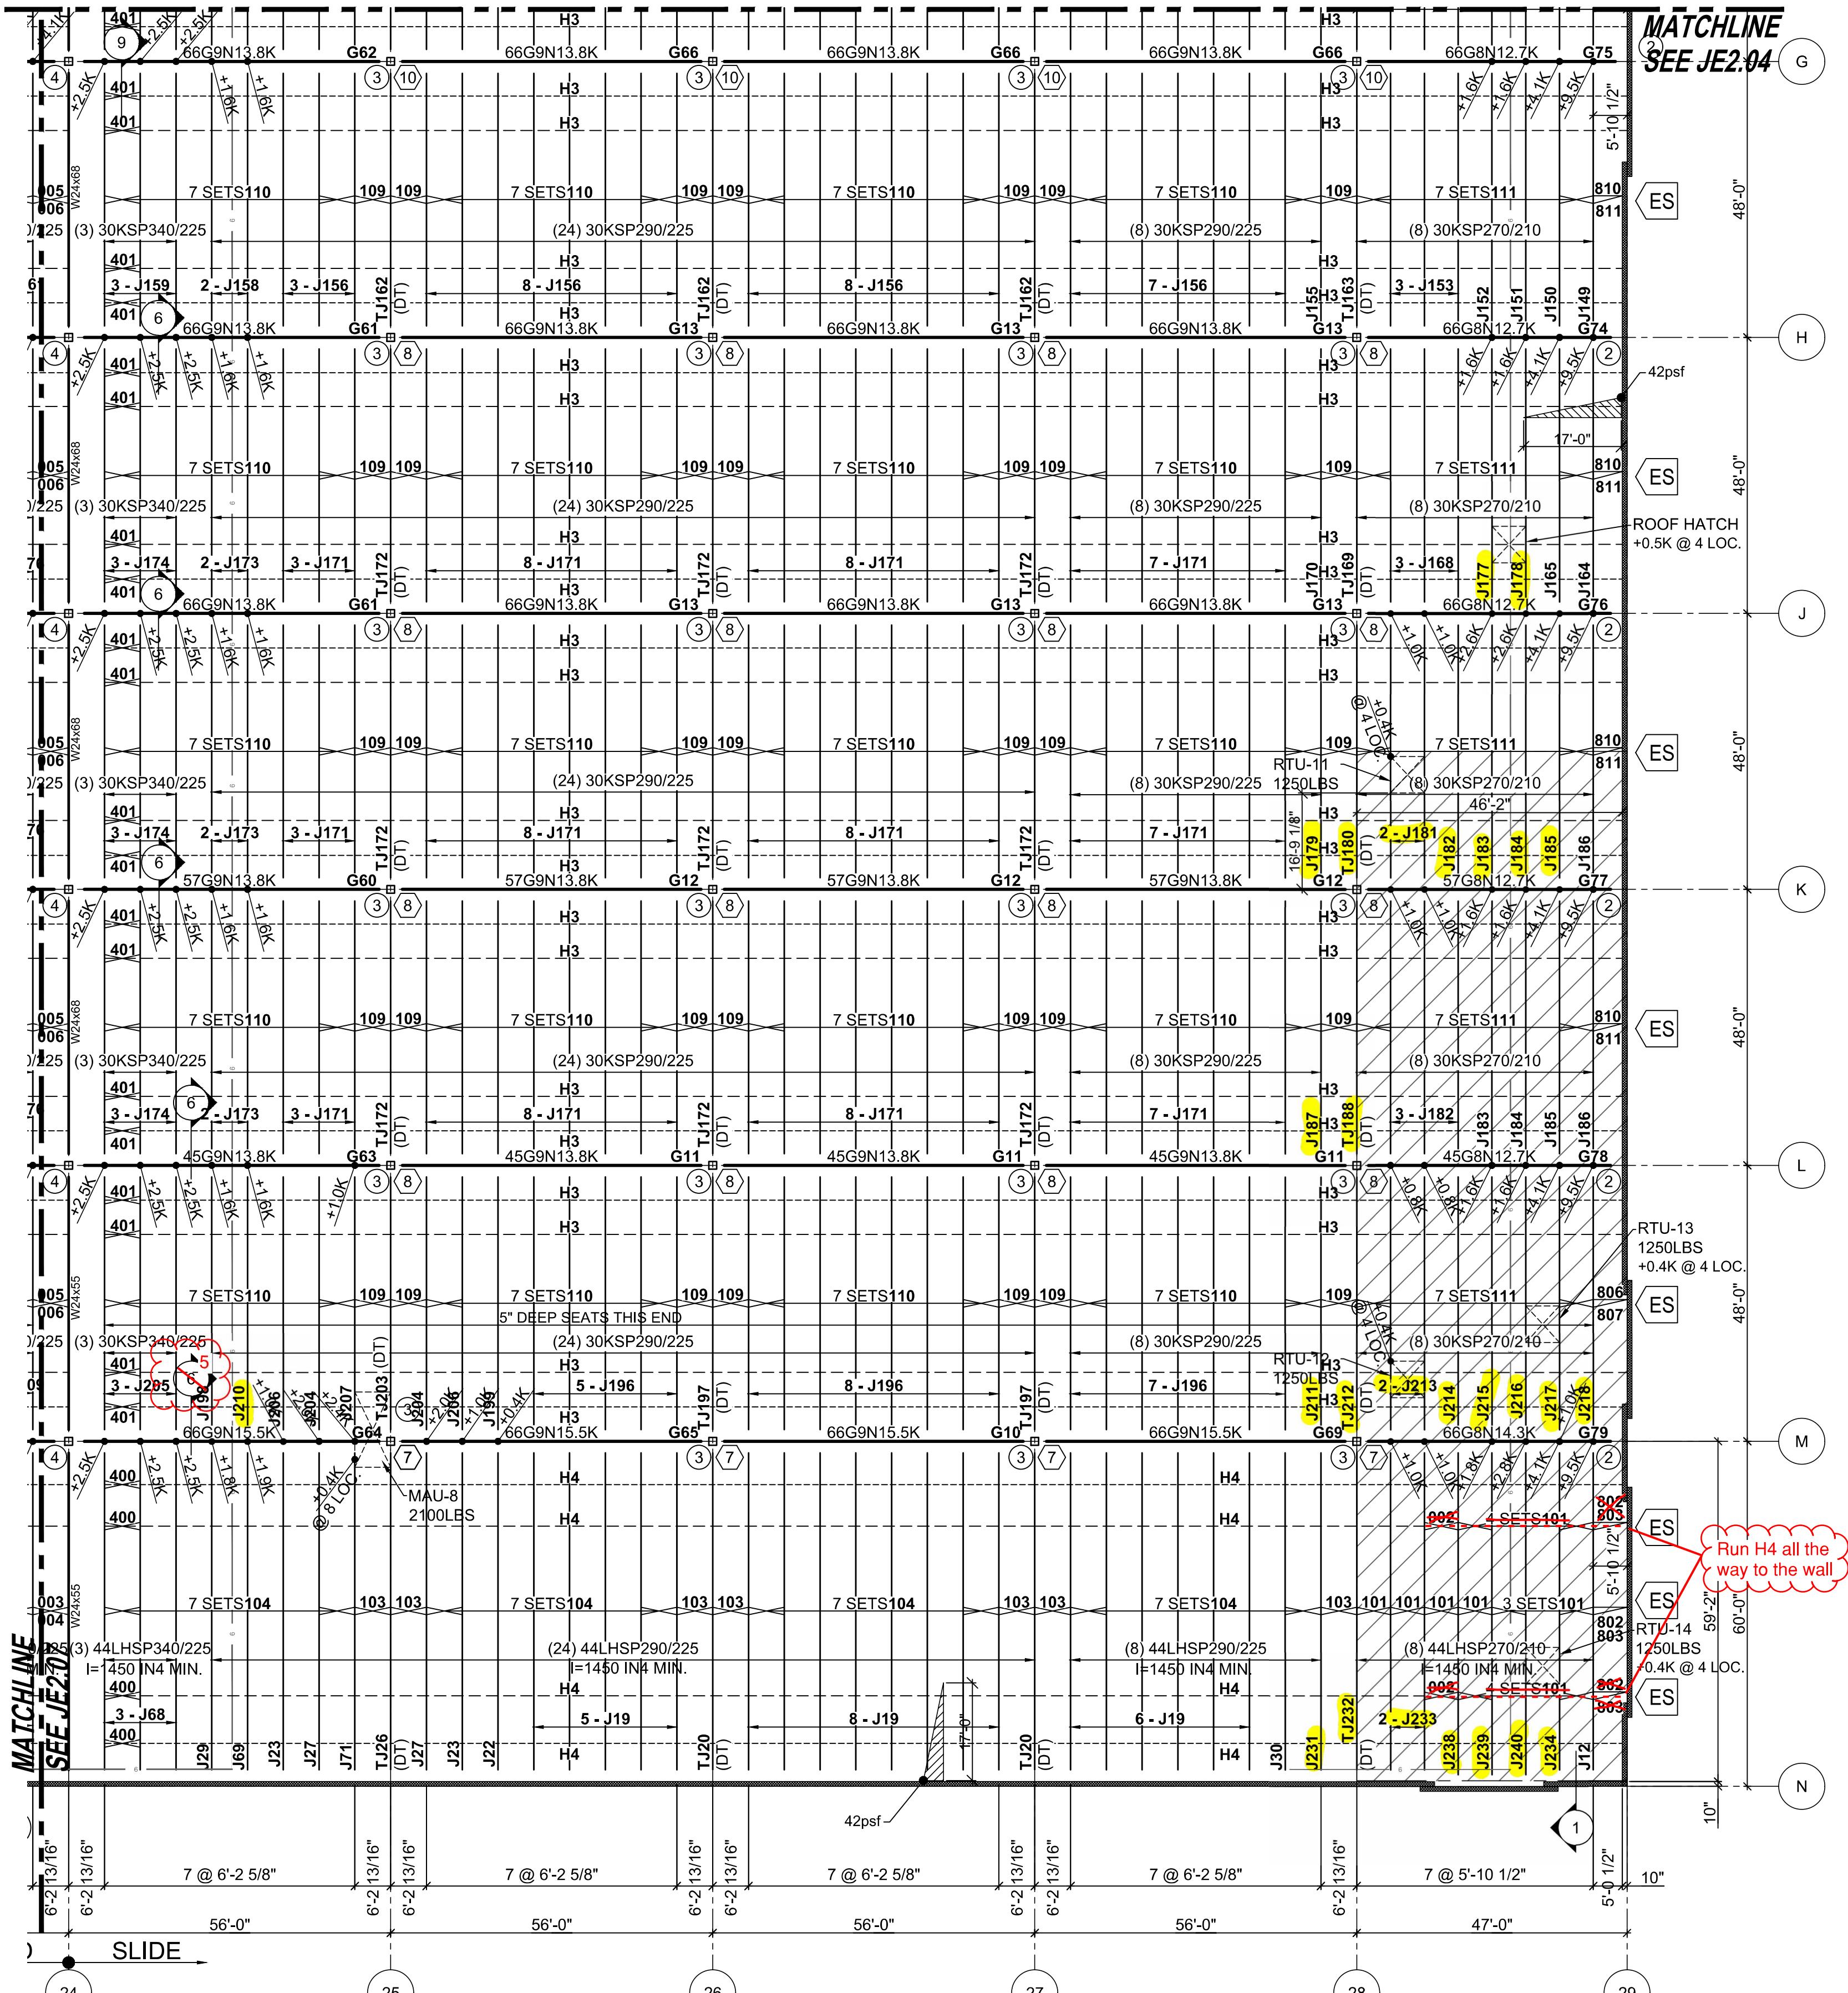

ROOF JOIST FRAMING PLAN 'H'
REF: S2.20H SEQ: SEE PLAN


1. REFERENCE DWG JE1.01 FOR LEGEND, SYMBOLS, & ABBREVIATIONS.
2. REFERENCE TYPICAL JOIST REINFORCEMENT DETAIL ON JOIST DRAWING JE1.01.
3. THE TAG END OF THE JOIST IS THE END AT WHICH THE PIECEMARK IS LOCATED.
4. FOR SECURING SEEING JOIST.
5. ALL JOISTS WITH SPAN > 40'-0" AND GREATER TO HAVE BOLTED CONNECTION.
6. ALL JOISTS AND JOIST GIRDERS BEARING COLS ARE HSS 12x12 UNO.
7. DENOTES JOIST CONNECTION (SEE JOIST SECTIONS).
8. DENOTES GIRDERS CONNECTION (SEE JOIST SECTIONS).
9. KNEE BRACE ONLY IF REQD BY DESIGN. SEE PLAN FOR LOCATIONS.
10. DESIGN JOIST SEATS FOR 3.25K ROLLOVER (1.0 WIND) & 2.0K (1.0 SEISMIC) @ GRIDLINES A & N.
11. INDICATES SNOW DRIFT.
12. ALL JOIST ENDS AND TOP CHORDS TO BE DESIGNED FOR AXIAL FORCE OF 4.0K (1.0 WIND) AND 7.5K (1.0 SEISMIC) FOR JOISTS BETWEEN LINE A & B AND M & N.
13. LIMIT JOIST & GIRDERS DEFLECTION TO L/240 UNDER LIVE OR SNOW LOAD AND L/360 AT OFFICE AREAS WHERE INDICATED ON PLAN.

NET UPLIFT = SEE DIAGRAM
ON DWG JE3.03

ADDITIONAL BRIDGING DUE TO UPLIFT
SEE JE3.02 FOR JOIST/BRIDGING DIAGRAM

1	8	16	24	29
A G	B F	C G	D H	
JE2.01 JE2.05	JE2.02 JE2.06	JE2.03 JE2.07	JE2.04 JE2.08	

KEY PLAN

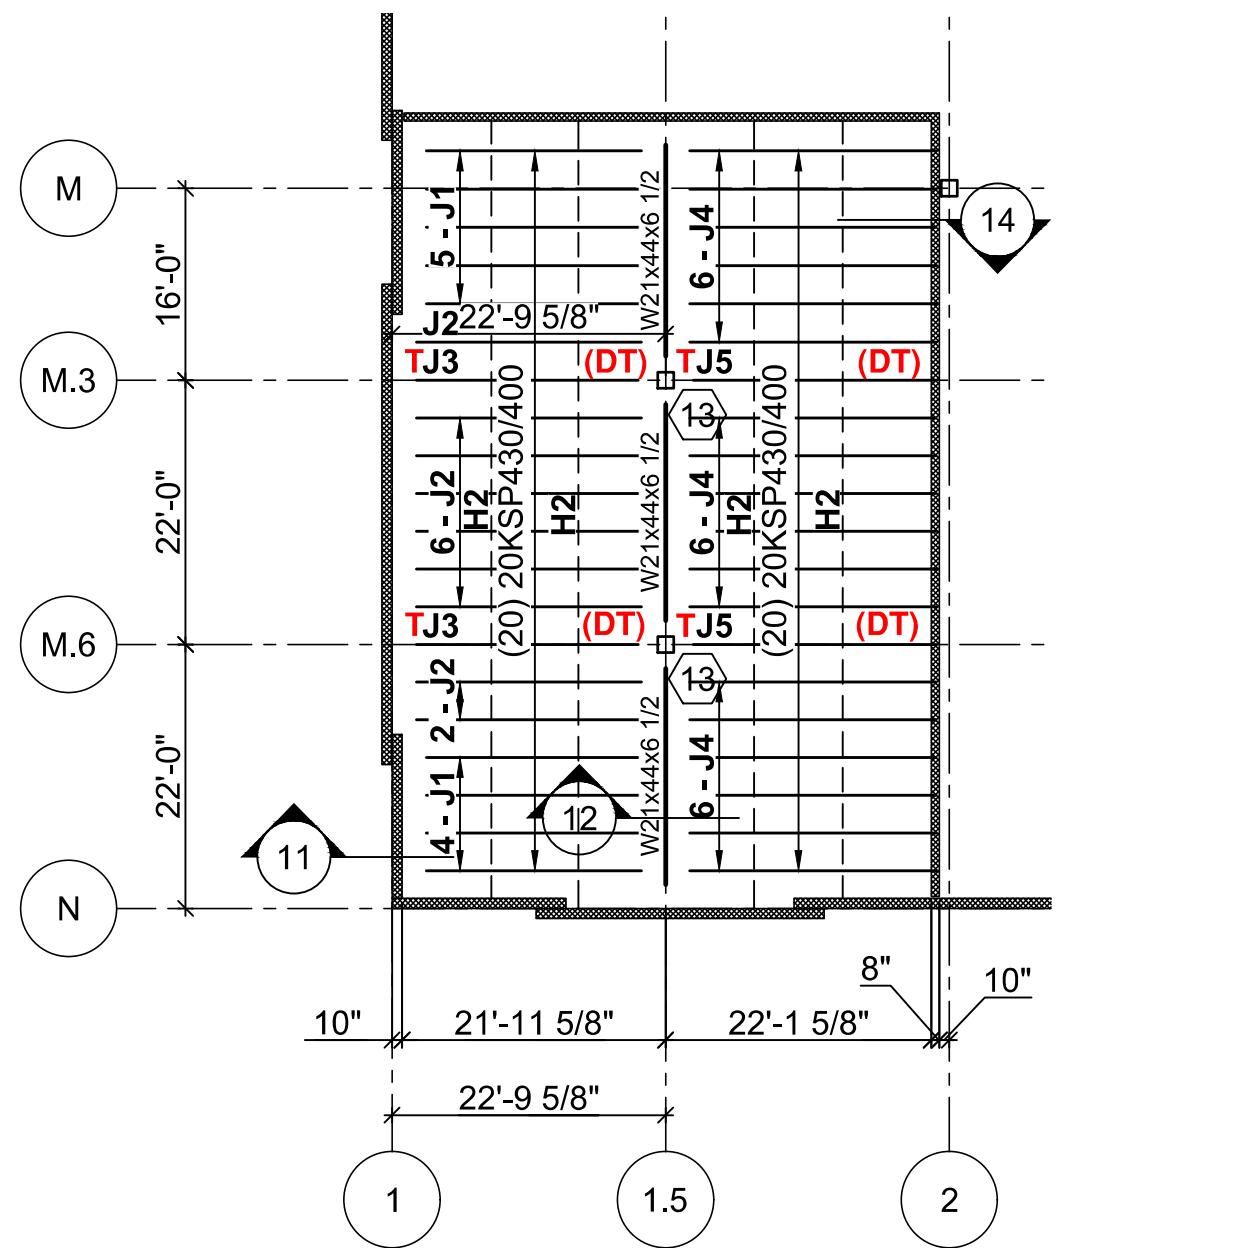

MEZZANINE JOIST FRAMING PLAN

REF: S2.11

SE0

REF: S2.11

~~=Q. 1~~


1. REFERENCE DWG JE1.01 FOR LEGEND, SYMBOLS, & ABBREVIATIONS.
2. REFERENCE "TYPICAL JOIST REINFORCEMENT" DETAIL ON JOIST DRAWING JE1.01.
3. THE TAG END OF THE JOIST IS THE END AT WHICH THE PIECEMARK IS LOCATED.
4. FOR SECTIONS SEE DWG JE3.01
5. ALL JOISTS AND JOIST GIRDER BEARING COL'S ARE HSS 8x8 UNO.
6.  DENOTES JOIST CONNECTION (SEE JOIST SECTIONS).

● — — — CONT. HORIZONTAL BRIDGING
TYP @ TOP AND BOTTOM CHORDS.
H2 = L1 1/4x1 1/4x0.109


FOR APPROVAL ONLY NOT FOR FIELD USE

DATE SENT FOR FIELD USE:


DATE SENT FOR APPROVAL:

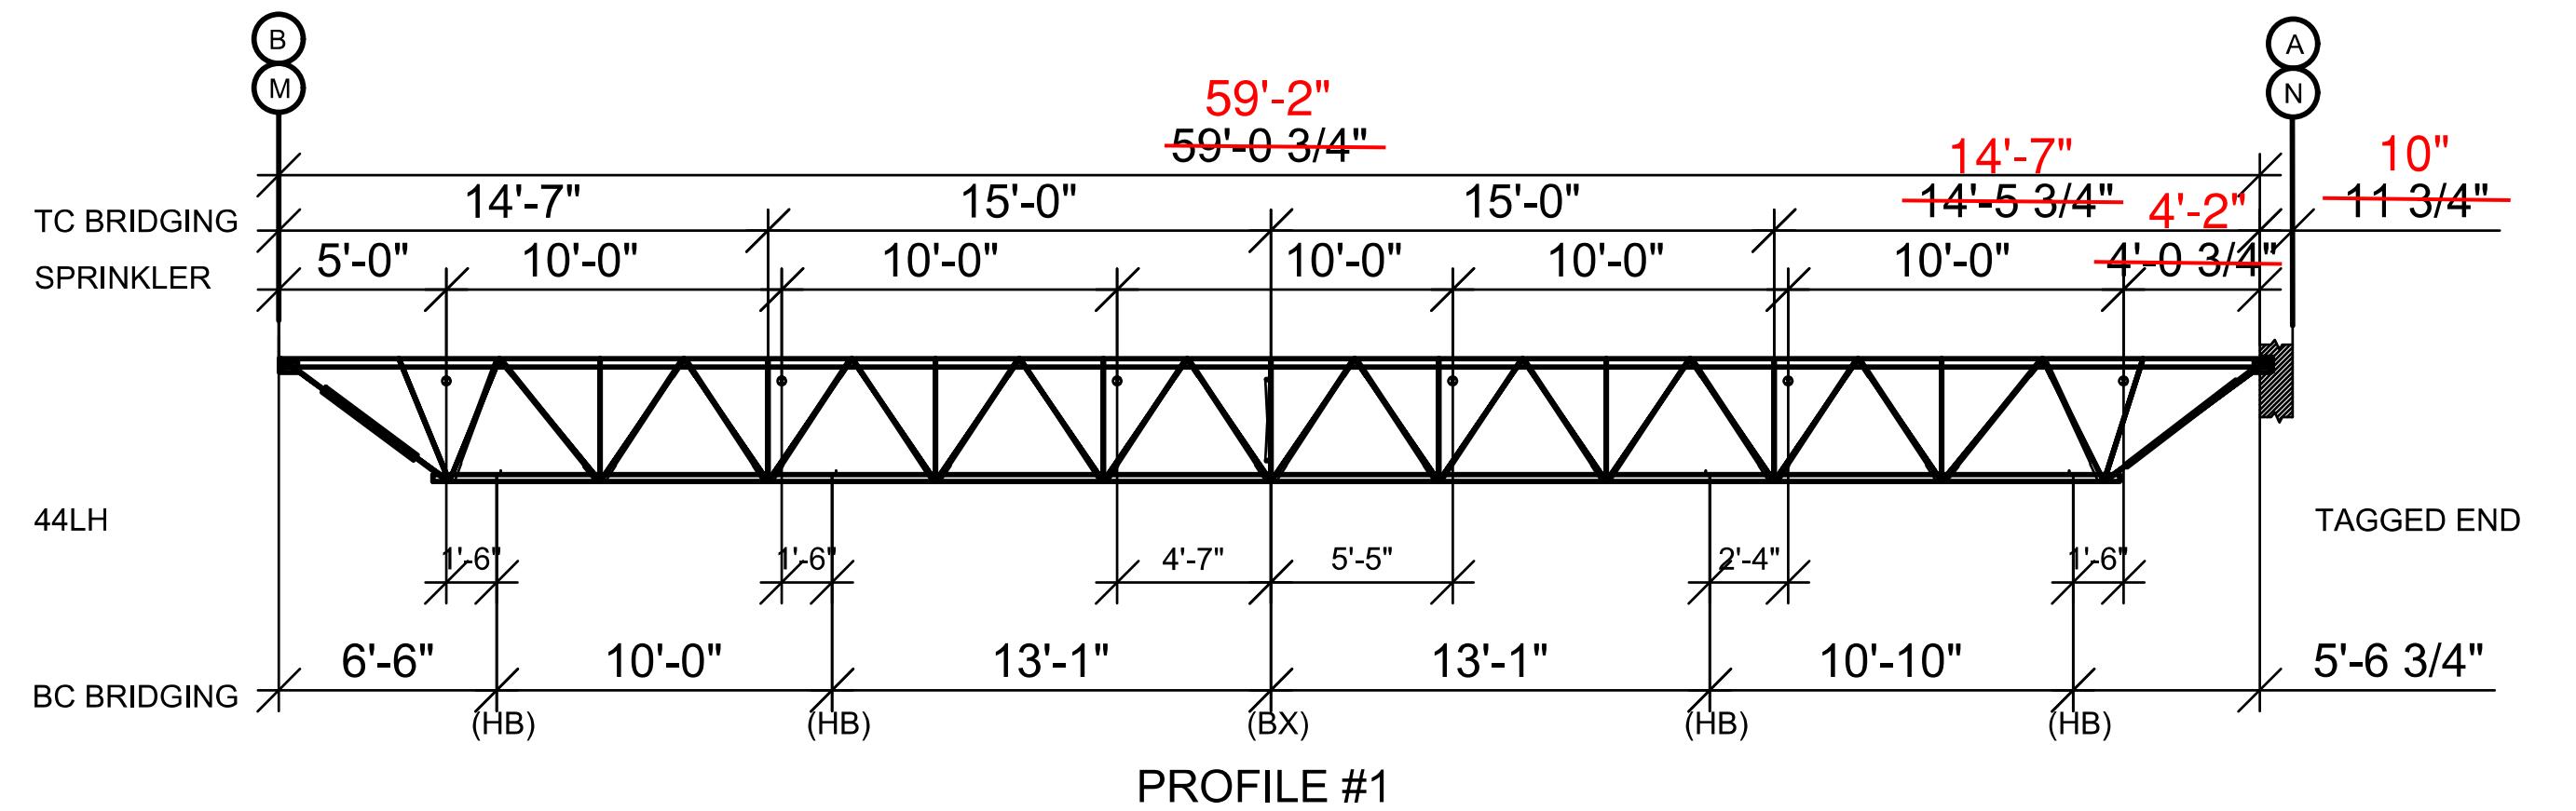

See revised Cad
file in folder 2.01
(Rev 2). I only
made revisions
to profile B-A in
the cad file.

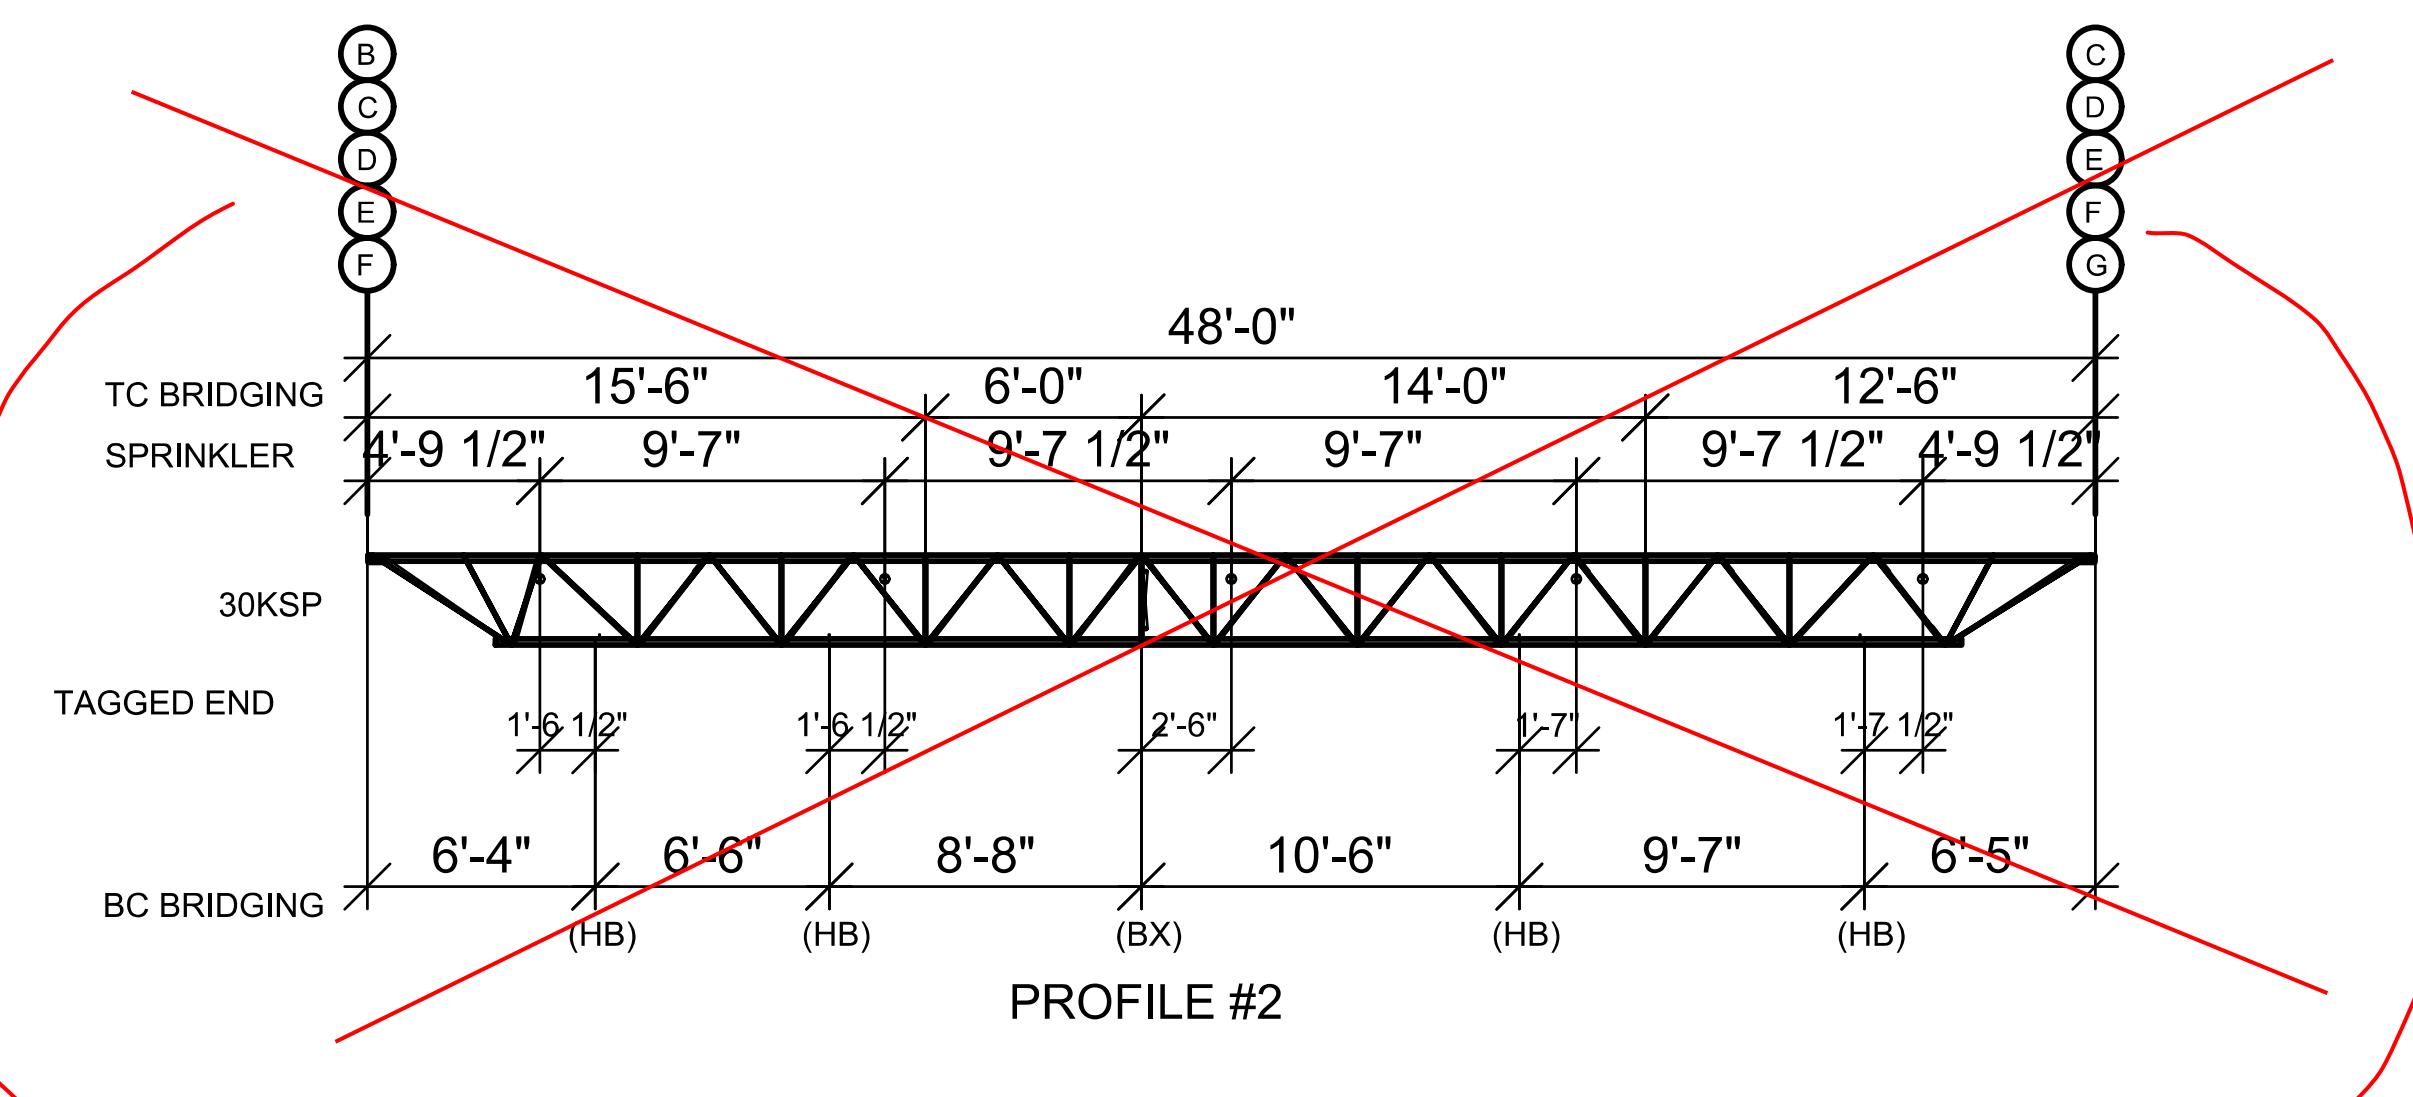


Add grid lines B thru
G to this profile

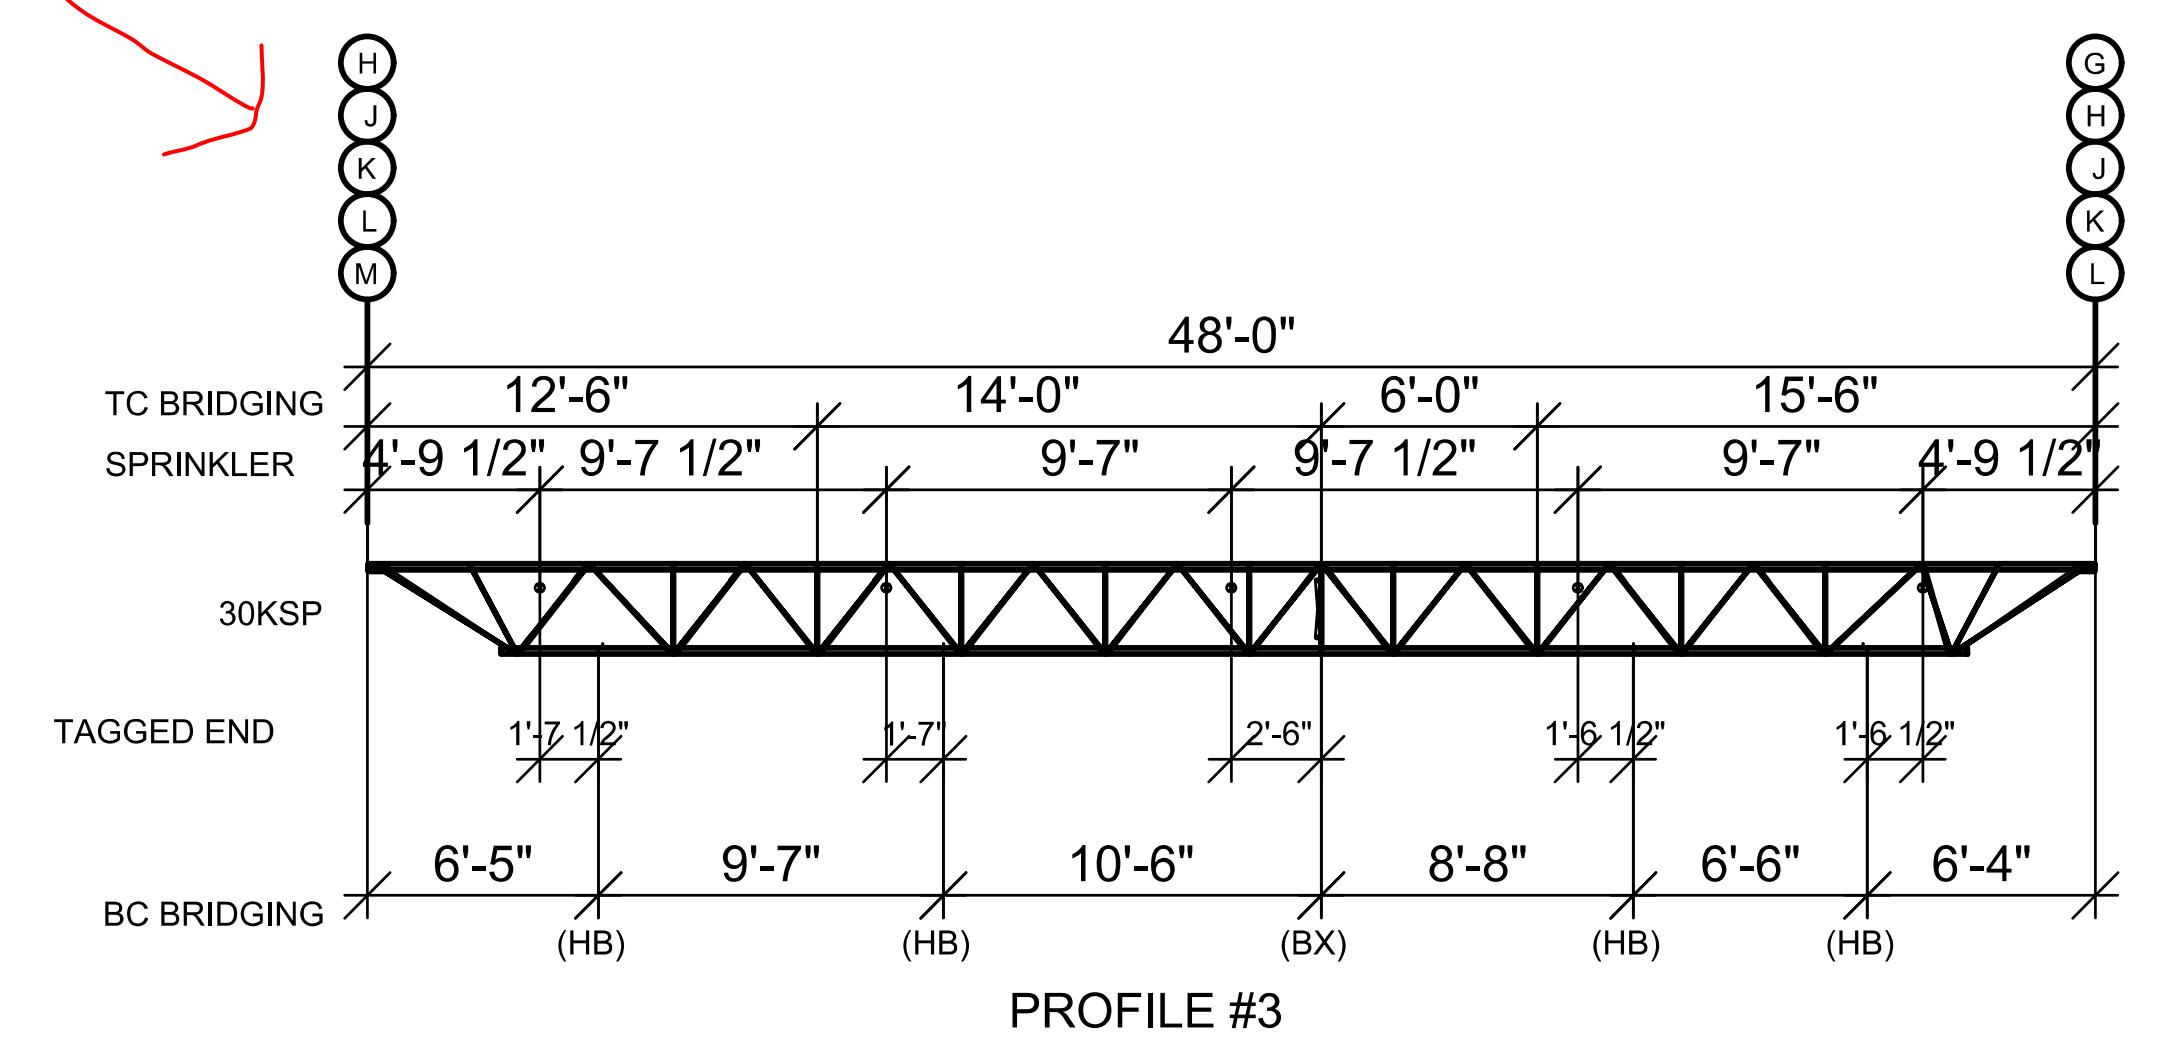


This profile doesn't match the profile
in cad so don't use that one when
making revisions

REVISION NO.	DATE	DESCRIPTION
FOR APPROVAL ONLY NOT FOR FIELD USE		
DATE SENT FOR FIELD USE:		
DATE SENT FOR APPROVAL:		

JOIST/BRIDGING PROFILES

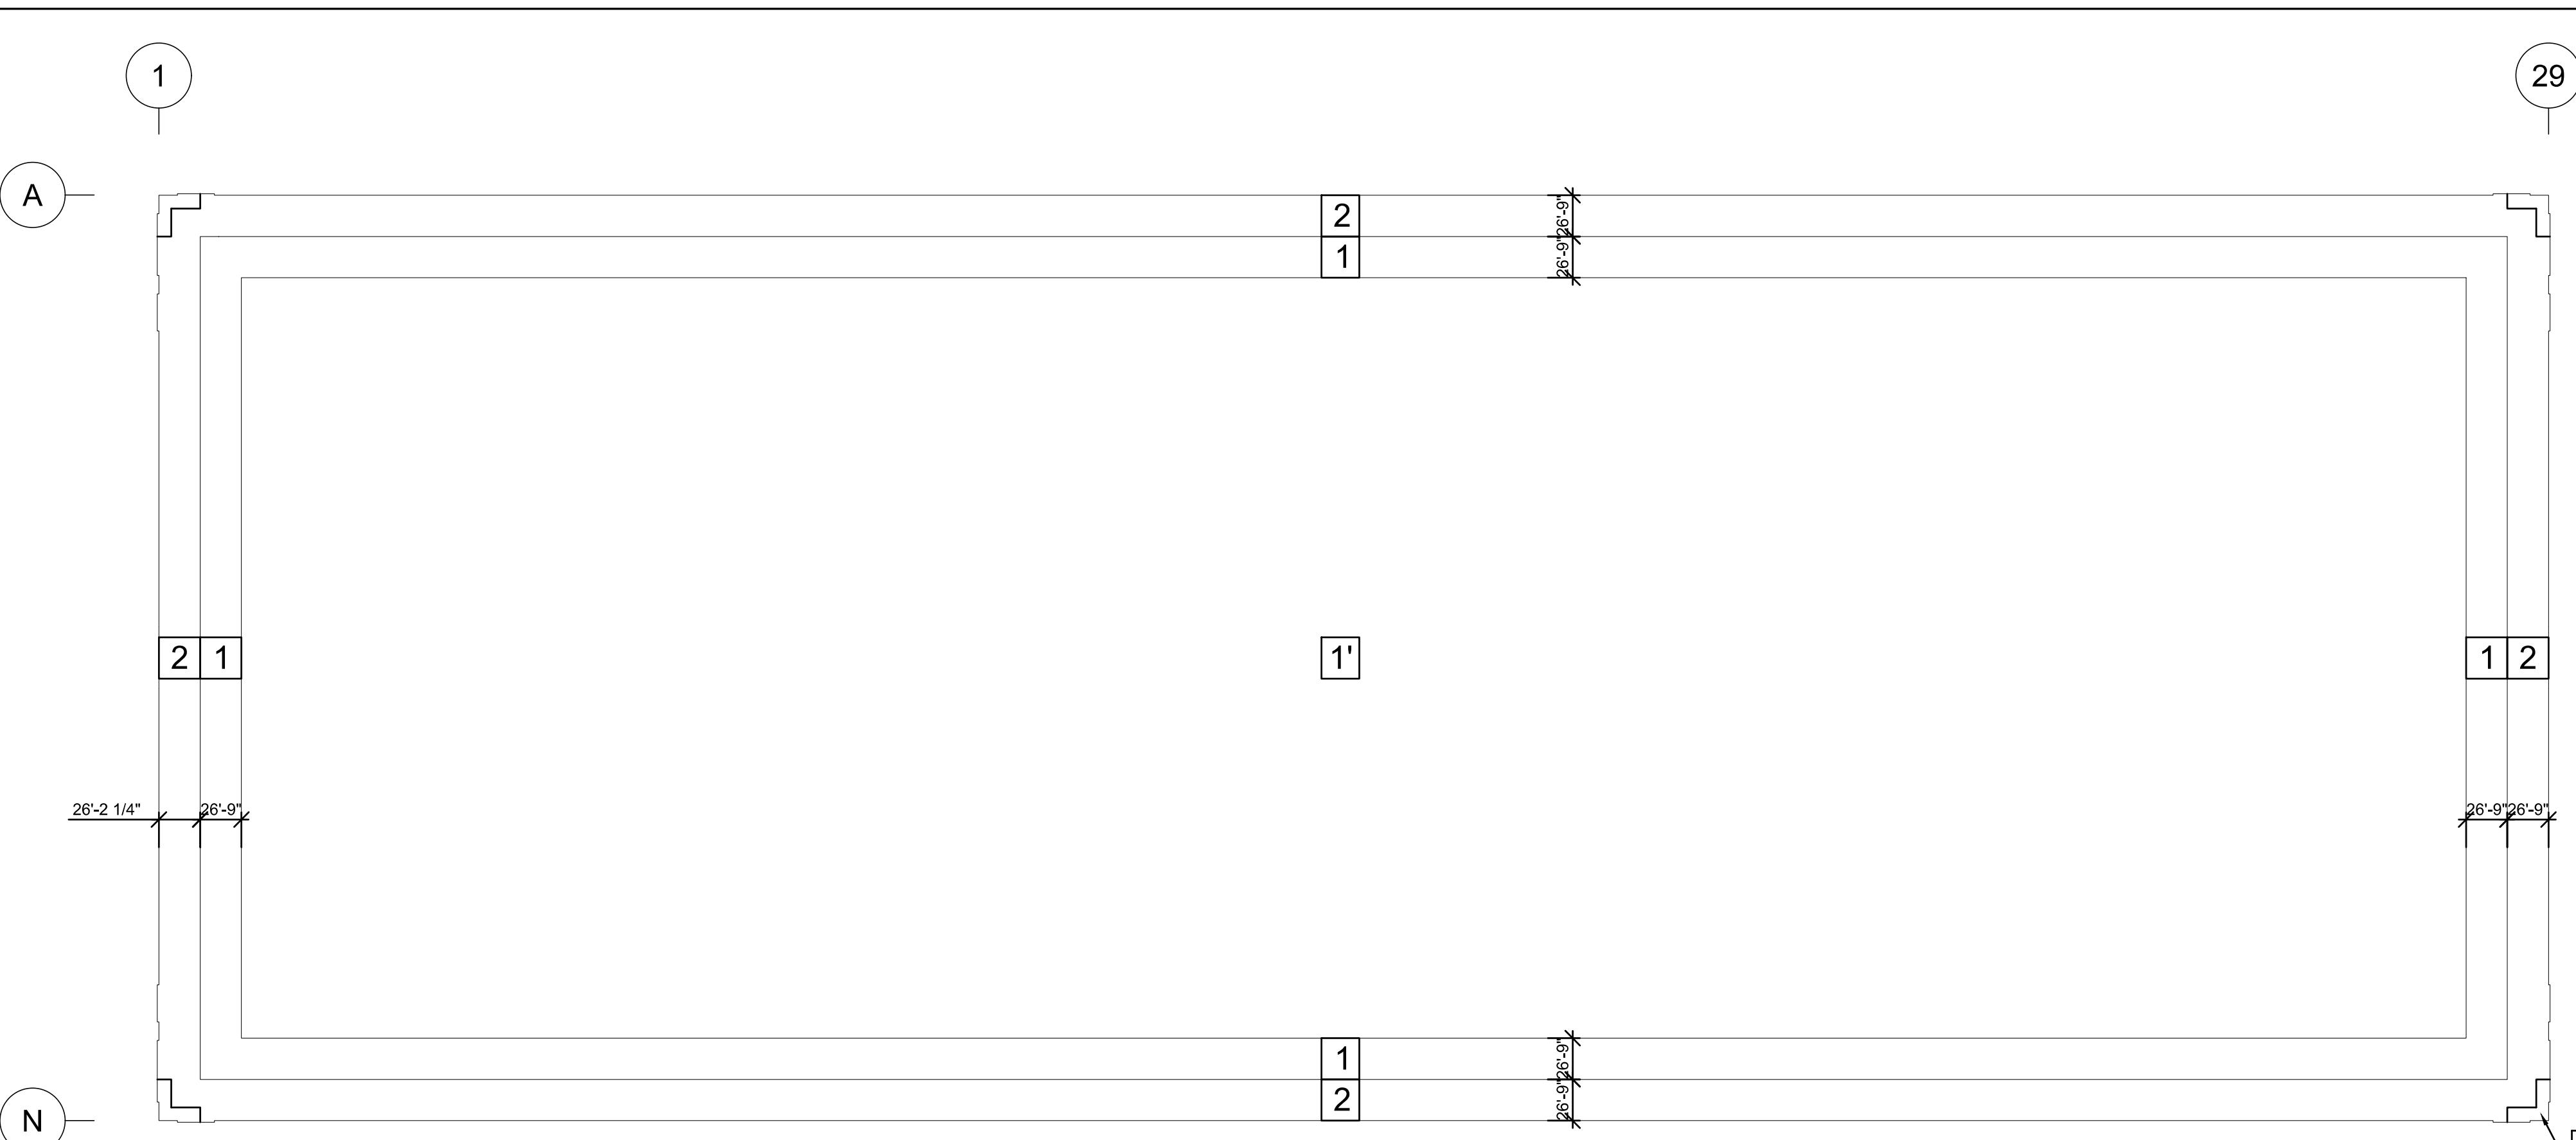

JOIST WIND UPLIFT (TO BE USED IN JOIST DESIGN)			
ZONE 1'	ZONE 1	ZONE 2	ZONE 3
INT. ROOF	INT. ROOF	EDGE ROOF	CORNER ROOF
10.5 PSF	18.0 PSF	25.5 PSF	27.0 PSF

 

JOIST UPLIFT PLAN
REF: 1/S2.31


12.8 PSF

REVISION NO.	DATE	DESCRIPTION

**FOR APPROVAL ONLY
NOT FOR FIELD USE**



DATE SENT FOR FIELD USE: _____
DATE SENT FOR APPROVAL: _____

JOIST GIRDER UPLIFT PLAN
REF: 2/S2.31

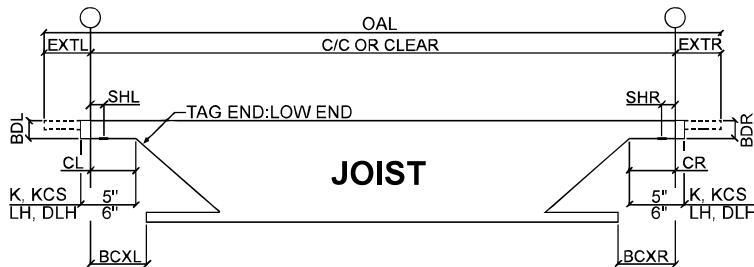

LENGTHS SHOWN ARE IN HORIZONTAL PROJECTION
DT = Danger Tag (per OSHA)


FL & FR = Type S, F & R
or dimension to end of
shoes from center line.

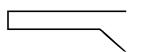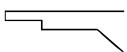

TYPE "S" EXT

TYPE "F" & "R" EXT

Seat Standards UNLESS NOTED ON THE LIST
BDL, BDR: H & K = 2 1/2"
LH & DLH = 5"
SLOTS: H & K = 5/8", 3 1/2" Gage
LH & DLH = 7/8", 4" Gage

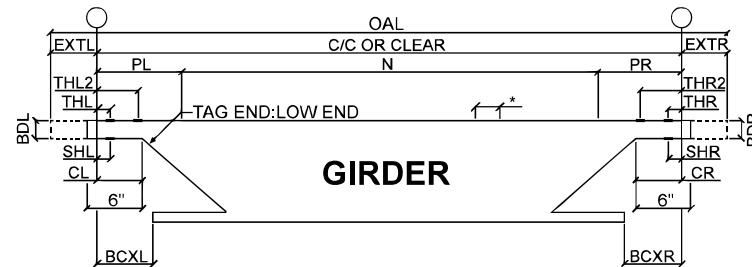

LENGTHS SHOWN ARE IN HORIZONTAL PROJECTION

***OSHA JOIST TO GIRDER CONNECTION**
WS= Welded Seats
NS= Joist Bolted on Near Side
FS= Joist Bolted on Far Side
BS= Joist Bolted on Both Sides

Seat Standards UNLESS NOTED ON THE LIST
BDL, BDR:= 7 1/2"
SLOTS: = 7/8", 5"
THL, THR: = 5/8" Holes, 5" Gage
Holes for LH Series Must be Noted

C/C or Clear = C/C of Grid or Inside Face of Wall
OAL = Over All Length
N = Number of Joist Spacings

EXTL = EXtension Top Left
CL = Clearance Left
BDL = Bearing Depth Left
SHL = Seat Holes Left
BCXL = Bottom Chord EXtension Left
THL = Top Chord Hole Left (Girder)
THL2 = Top Chord Hole Left 2nd (Girder)
PL = Panel Left (Girder)

EXTR = EXtension Top Right
CR = Clearance Right
BDR = Bearing Depth Right
SHR = Seat Holes Right
BCXR = Bottom Chord EXtension Right
THR = Top Chord Hole Right (Girder)
THR2 = Top Chord Hole Right 2nd (Girder)
PR = Panel Right (Girder)

NOTES:	NET UPLIFT: _____ PLF																														
	ASD <input checked="" type="checkbox"/>	LRFD <input type="checkbox"/>	FACTORED <input type="checkbox"/>																												
Refer to joist notes list																															
LIMIT JOIST DEFLECTION TO L/240 UNDER LIVE OR SNOW LOAD UNO WITH JOIST																															
NOTE DF1.																															
SEQUENCE	QTY	MARK	TYPE	ELEV. SLOPE	EXTL	C/C OR CLEAR	EXTR	FL / TYPE	CL	FR / TYPE	CR	BDL	BDR	SHL	SHR	BCXL	BCXR	OAL	NOTES												
---	---	---	9 J1	20KSP430/400	---	-1/2"	21'-11 5/8"	-1/4"	F	6"	F	5 1/4"	2 1/2"	2 1/2"	---	---	---	---	21'-10 7/8"	(UP1) L/360											
---	---	---	9 J2	20KSP430/400	---	-1/2"	22'-9 5/8"	-1/4"	F	6"	F	5 1/4"	2 1/2"	2 1/2"	---	---	---	---	22'-8 7/8"	(UP1) L/360											
---	---	---	2 TJ3	20KSP430/400	---	-1/2"	22'-9 5/8"	-3 1/2"	F	6"	F	7"	2 1/2"	2 1/2"	---	5 1/2"	1 1/2"	4 1/2"	22'-5 5/8"	(UP1) L/360, DT											
---	---	---	18 J4	20KSP430/400	---	-1/4"	22'-1 5/8"	5"	F	5 1/4"	F	0"	2 1/2"	2 1/2"	---	---	---	---	22'-6 3/8"	(UP1) L/360											
---	---	---	2 TJ5	20KSP430/400	---	-3 1/2"	22'-1 5/8"	5"	F	7"	F	0"	2 1/2"	2 1/2"	5 1/2"	---	4 1/2"	1 1/2"	22'-3 1/8"	(UP1) L/360, DT											
---	---	---	1 J6	44LHSP270/210	---	-1/2"	60'-0"	-1/4"	F	5"	F	6 1/4"	5"	5"	---	2 1/2"	---	---	59'-11 1/4"	(AX1), (BR1), (DF1), (IN1), (NU1) (R1) (SD5), (SD8), (SP1), (SP3)											
---	---	---	1 J7	44LHSP270/210	---	-1/2"	60'-0"	-1/4"	F	5"	F	6 1/4"	5"	5"	---	2 1/2"	---	---	59'-11 1/4"	(AX1), (BR1), (DF1), (IN1), (NU1), (P1) (R1) (SD1), (SD11), (SD6), (SP1), (SP3)											
---	---	---	1 J8	44LHSP270/210	---	-1/2"	60'-0"	-1/4"	F	5"	F	6 1/4"	5"	5"	---	2 1/2"	---	---	59'-11 1/4"	(AX1), (BR1), (DF1), (IN1), (NU2), (P1), (R1) (SD1), (SD11), (SD54), (SP3)											
---	---	---	1 J9	44LHSP270/210	---	-1/2"	60'-0"	-1/4"	F	5"	F	6 1/4"	5"	5"	---	2 1/2"	---	---	59'-11 1/4"	(AX1), (BR1), (DF1), (IN1), (NU1), (P1) (R1) (SD2), (SD3), (SD4), (SD5), (SD7), (SP1), (SP4)											
---	---	---	1 J10	44LHSP270/210	---	-1/2"	60'-0"	-1/4"	F	5"	F	6 1/4"	5"	5"	---	2 1/2"	---	---	59'-11 1/4"	(AX1), (BR1), (DF1), (IN1), (NU1), (P1) (R1) (SD2), (SD40), (SD41), (SD74), (SP1), (SP4)											
---	---	---	1 J11	44LHSP270/210	---	-1/2"	60'-0"	-1/4"	F	5"	F	6 1/4"	5"	5"	---	2 1/2"	---	---	59'-11 1/4"	(AX1), (BR1), (DF1), (IN1), (NU1), (R1) (SD5), (SD8), (SP1), (SP4)											
---	---	---	3 J12	44LHSP270/210	---	-1/2"	59'-2"	-1/4"	F	5"	F	6 1/4"	5"	5"	---	2 1/2"	---	---	59'-1 1/4"	(AX1), (BR1), (DF1), (IN1), (NU1) (R1) (SD3), (SD6)											
---	---	---	2 J13	44LHSP270/210	---	-1/2"	59'-2"	-1/4"	F	5"	F	6 1/4"	5"	5"	---	2 1/2"	---	---	59'-1 1/4"	(AX1), (BR1), (DF1), (IN1), (NU1) (R1) (SD4), (SD7)											
---	---	---	1 J14	44LHSP270/210	---	-1/2"	59'-2"	-1/4"	F	5"	F	6 1/4"	5"	5"	---	2 1/2"	---	---	59'-1 1/4"	(AX1), (BR1), (DF1), (IN1), (NU2), (P1) (R1) (SD1), (SD12), (SD13), (SD55), (SP3)											
---	---	---	1 J15	44LHSP270/210	---	-1/2"	59'-2"	-1/4"	F	5"	F	6 1/4"	5"	5"	---	2 1/2"	---	---	59'-1 1/4"	(AX1), (BR1), (DF1), (IN1), (NU2), (P1) (R1) (SD1), (SD12), (SD13), (SD56), (SD57), (SP3)											
---	---	---	1 TJ16	44LHSP270/210	---	-1/2"	59'-2"	-1/4"	F	5"	F	6 1/4"	5"	5"	---	2 1/2"	---	7 1/2"	59'-1 1/4"	(AX1), (BR1), (DF1), (IN1), (NU2) (R1) (SD1), (SD58), (SP3), DT											
---	---	---	1 J17	44LHSP290/225	---	-1/2"	59'-2"	-1/4"	F	5"	F	6 1/4"	5"	5"	---	2 1/2"	---	---	59'-1 1/4"	(AX1), (BR1), (IN1), (NU2), (R1) (SD1), (SD59), (SP3)											
---	---	---	2 J18	44LHSP290/225	---	-1/2"	59'-2"	-1/4"	F	5"	F	6 1/4"	5"	5"	---	2 1/2"	---	---	59'-1 1/4"	(AX1), (BR1), (IN1), (NU2) (R1) (SD1), (SP3)											
---	---	---	186 J19	44LHSP290/225	---	-1/2"	59'-2"	-1/4"	F	5"	F	6 1/4"	5"	5"	---	2 1/2"	---	---	59'-1 1/4"	(AX1), (BR1), (IN1), (NU2), (R1), (SD1)											
---	---	---	22 TJ20	44LHSP290/225	---	-1/2"	59'-2"	-1/4"	F	5"	F	6 1/4"	5"	5"	---	2 1/2"	---	7 1/2"	59'-1 1/4"	(AX1), (BR1), (IN1), (NU2), (R1), (SD1), DT											

NOTES:		NET UPLIFT: _____ PLF																	
		ASD <input checked="" type="checkbox"/> LRFD <input type="checkbox"/> FACTORED <input type="checkbox"/>																	
Refer to joist notes list																			
LIMIT JOIST DEFLECTION TO L/240 UNDER LIVE OR SNOW LOAD UNO WITH JOIST																			
NOTE DF1.																			
SEQUENCE	QTY	MARK	TYPE	ELEV. SLOPE	EXTL	C/C OR CLEAR	EXTR	FL / TYPE	CL	FR / TYPE	CR	BDL	BDR	SHL	SHR	BCXL	BCXR	OAL	NOTES
---	---	---	---	---	---	---	---	---	---	---	---	---	---	---	---	---	---	---	
---	---	5	J21	44LHSP290/225	---	-1/2"	59'-2"	-1/4"	F	5"	F	6 1/4"	5"	5"	---	2 1/2"	---	---	59'-1 1/4" (AX1), (BR1), (IN1), (NU2), (R1), (SD1), (SP1)
---	---	6	J22	44LHSP290/225	---	-1/2"	59'-2"	-1/4"	F	5"	F	6 1/4"	5"	5"	---	2 1/2"	---	---	59'-1 1/4" (AX1), (BR1), (IN1), (NU2), (R1), (SD1), (SD49)
---	---	8	J23	44LHSP290/225	---	-1/2"	59'-2"	-1/4"	F	5"	F	6 1/4"	5"	5"	---	2 1/2"	---	---	59'-1 1/4" (AX1), (BR1), (IN1), (NU2), (R1), (SD1), (SD48)
---	---	1	J24	44LHSP290/225	---	-1/2"	59'-2"	-1/4"	F	5"	F	6 1/4"	5"	5"	---	2 1/2"	---	---	59'-1 1/4" (AX1), (BR1), (IN1), (NU2), (R1), (SD1), (SD47), (SP1)
---	---	1	J25	44LHSP290/225	---	-1/2"	59'-2"	-1/4"	F	5"	F	6 1/4"	5"	5"	---	2 1/2"	---	---	59'-1 1/4" (AX1), (BR1), (IN1), (NU2), (P1), (R1), (SD1), (SD32), (SD46), (SP1)
---	---	4	TJ26	44LHSP290/225	---	-1/2"	59'-2"	-1/4"	F	5"	F	6 1/4"	5"	5"	---	2 1/2"	7 1/2"	59'-1 1/4" (AX1), (BR1), (IN1), (NU2), (P1), (R1), (SD1), (SD32), (SD46), DT	
---	---	5	J27	44LHSP290/225	---	-1/2"	59'-2"	-1/4"	F	5"	F	6 1/4"	5"	5"	---	2 1/2"	---	---	59'-1 1/4" (AX1), (BR1), (IN1), (NU2), (R1), (SD1), (SD47)
---	---	18	J28	44LHSP340/225	---	-1/2"	59'-2"	-1/4"	F	5"	F	6 1/4"	5"	5"	---	2 1/2"	---	---	59'-1 1/4" (AX1), (BR1), (IN1), (NU2), (R1), (SD1)
---	---	15	J29	44LHSP290/225	---	-1/2"	59'-2"	-1/4"	F	5"	F	6 1/4"	5"	5"	---	2 1/2"	---	---	59'-1 1/4" (AX1), (BR1), (IN1), (NU2), (R1), (SD1), (SP1), (SP4)
---	---	45	J30	44LHSP290/225	---	-1/2"	59'-2"	-1/4"	F	5"	F	6 1/4"	5"	5"	---	2 1/2"	---	---	59'-1 1/4" (AX1), (BR1), (IN1), (NU2), (R1), (SD1), (SP1), (SP4)
---	---	1	J31	44LHSP290/225	---	-1/2"	59'-2"	-1/4"	F	5"	F	6 1/4"	5"	5"	---	2 1/2"	---	---	59'-1 1/4" (AX1), (BR1), (IN1), (NU2), (R1), (SD1), (SP2), (SP4)
---	---	2	TJ38	44LHSP290/225	---	-1/2"	59'-2"	-1/4"	F	5"	F	6 1/4"	5"	5"	---	2 1/2"	7 1/2"	59'-1 1/4" (AX1), (BR1), (IN1), (NU2), (R1), (SD1), (SP1), DT	
---	---	1	TJ39	44LHSP290/225	---	-1/2"	59'-2"	-1/4"	F	5"	F	6 1/4"	5"	5"	---	2 1/2"	7 1/2"	59'-1 1/4" (AX1), (BR1), (DF1), (IN1), (NU2), (R1), (SD1), DT	
---	---	3	J40	44LHSP290/225	---	-1/2"	59'-2"	-1/4"	F	5"	F	6 1/4"	5"	5"	---	2 1/2"	---	---	59'-1 1/4" (AX1), (BR1), (DF1), (IN1), (NU2), (R1), (SD1)

NOTES:		NET UPLIFT: _____ PLF																	
		ASD <input checked="" type="checkbox"/> LRFD <input type="checkbox"/> FACTORED <input type="checkbox"/>																	
Refer to joist notes list																			
LIMIT JOIST DEFLECTION TO L/240 UNDER LIVE OR SNOW LOAD UNO WITH JOIST																			
NOTE DF1.																			
SEQUENCE	QTY	MARK	TYPE	ELEV. SLOPE	EXTL	C/C OR CLEAR	EXTR	FL / TYPE	CL	FR / TYPE	CR	BDL	BDR	SHL	SHR	BCXL	BCXR	OAL	NOTES
---	---	---	---	---	---	---	---	---	---	---	---	---	---	---	---	---	---	---	
---	---	1	J41	44LHSP290/225	---	-1/2"	59'-2"	-1/4"	F	5"	F	6 1/4"	5"	5"	---	2 1/2"	---	---	59'-1 1/4"
---	---	1	J42	44LHSP290/225	---	-1/2"	59'-2"	-1/4"	F	5"	F	6 1/4"	5"	5"	---	2 1/2"	---	---	59'-1 1/4"
---	---	1	J43	44LHSP290/225	---	-1/2"	59'-2"	-1/4"	F	5"	F	6 1/4"	5"	5"	---	2 1/2"	---	---	59'-1 1/4"
---	---	1	J44	44LHSP290/225	---	-1/2"	59'-2"	-1/4"	F	5"	F	6 1/4"	5"	5"	---	2 1/2"	---	---	59'-1 1/4"
---	---	1	J45	44LHSP290/225	---	-1/2"	59'-2"	-1/4"	F	5"	F	6 1/4"	5"	5"	---	2 1/2"	---	---	59'-1 1/4"
---	---	1	TJ46	44LHSP290/225	---	-1/2"	59'-2"	-1/4"	F	5"	F	6 1/4"	5"	5"	---	2 1/2"	---	7 1/2"	59'-1 1/4"
---	---	1	J47	44LHSP290/225	---	-1/2"	59'-2"	-1/4"	F	5"	F	6 1/4"	5"	5"	---	2 1/2"	---	---	59'-1 1/4"
---	---	1	J48	44LHSP290/225	---	-1/2"	59'-2"	-1/4"	F	5"	F	6 1/4"	5"	5"	---	2 1/2"	---	---	59'-1 1/4"
---	16	J58	44LH290/225SP	---	-1/2"	59'-2"	-1/4"	F	5"	F	6 1/4"	5"	5"	---	2 1/2"	---	---	59'-1 1/4"	
---	2	J59	44LH290/225SP	---	-1/2"	59'-2"	-1/4"	F	5"	F	6 1/4"	5"	5"	---	2 1/2"	---	---	59'-1 1/4"	
---	2	J60	44LH290/225SP	---	-1/2"	59'-2"	-1/4"	F	5"	F	6 1/4"	5"	5"	---	2 1/2"	---	---	59'-1 1/4"	

NOTES:	NET UPLIFT: _____ PLF																					
	ASD <input checked="" type="checkbox"/>	LRFD <input type="checkbox"/>	FACTORED <input type="checkbox"/>																			
Refer to joist notes list																						
LIMIT JOIST DEFLECTION TO L/240 UNDER LIVE OR SNOW LOAD UNO WITH JOIST																						
NOTE DF1.																						
SEQUENCE	QTY	MARK	TYPE	ELEV. SLOPE	EXTL	C/C OR CLEAR	EXTR	FL / TYPE	CL	FR / TYPE	CR	BDL	BDR	SHL	SHR	BCXL	BCXR	OAL	NOTES			
---	---	---	---	---	---	---	---	---	5"	F	6 1/4"	5"	5"	---	2 1/2"	---	---	59'-1 1/4"	(AX1), (BR1), (IN1), (NU2), (R1), (SD1), (SD47)			
---	---	1	J62	44LH290/225SP	---	-1/2"	59'-2"	-1/4"	F	5"	F	6 1/4"	5"	5"	---	2 1/2"	---	---	59'-1 1/4"	(AX1), (BR1), (IN1), (NU2), (P1), (R1), (SD1), (SD32), (SD46)		
---	---	1	TJ63	44LH290/225SP	---	-1/2"	59'-2"	-1/4"	F	5"	F	6 1/4"	5"	5"	---	2 1/2"	---	7 1/2"	59'-1 1/4"	(AX1), (BR1), (IN1), (NU2), (P1), (R1), (SD1), (SP4), DT		
---	---	2	TJ64	44LH290/225SP	---	-1/2"	59'-2"	-1/4"	F	5"	F	6 1/4"	5"	5"	---	2 1/2"	---	7 1/2"	59'-1 1/4"	(AX1), (BR1), (IN1), (NU2), (R1), (SD1), (SP4), DT		
---	---	1	J65	44LH290/225SP	---	-1/2"	59'-2"	-1/4"	F	5"	F	6 1/4"	5"	5"	---	2 1/2"	---	---	59'-1 1/4"	(AX1), (BR1), (IN1), (NU2), (R1), (SD1), (SP5)		
---	---	1	J66	44LHSP340/225	---	-1/2"	59'-2"	-1/4"	F	5"	F	6 1/4"	5"	5"	---	2 1/2"	---	---	59'-1 1/4"	(AX1), (BR1), (IN1), (NU2), (R1), (SD1), (SP5)		
---	5	J67	44LHSP340/225	---	-1/2"	59'-2"	-1/4"	F	5"	F	6 1/4"	5"	5"	---	2 1/2"	---	---	59'-1 1/4"	(AX1), (BR1), (IN1), (NU2), (R1), (SD1), (SP5)			
---	---	6	J68	44LHSP340/225	---	-1/2"	59'-2"	-1/4"	F	5"	F	6 1/4"	5"	5"	---	2 1/2"	---	---	59'-1 1/4"	(AX1), (BR1), (IN1), (NU2), (R1), (SD1), (SP4)		
---	---	2	J69	44LHSP290/225	---	-1/2"	59'-2"	-1/4"	F	5"	F	6 1/4"	5"	5"	---	2 1/2"	---	---	59'-1 1/4"	(AX1), (BR1), (IN1), (NU2), (R1), (SD1), (SD49), (SP1), (SP4)		
---	---	2	J70	44LHSP290/225	---	-1/2"	59'-2"	-1/4"	F	5"	F	6 1/4"	5"	5"	---	2 1/2"	---	---	59'-1 1/4"	(AX1), (BR1), (IN1), (NU2), (R1), (SD1), (SD51)		
---	---	3	J71	44LHSP290/225	---	-1/2"	59'-2"	-1/4"	F	5"	F	6 1/4"	5"	5"	---	2 1/2"	---	---	59'-1 1/4"	(AX1), (BR1), (IN1), (NU2), (P1), (R1), (SD1), (SD32), (SD46)		
---	---	1	TJ72	44LHSP270/210	---	-1/2"	59'-2"	-1/4"	F	5"	F	6 1/4"	5"	5"	---	2 1/2"	---	7 1/2"	59'-1 1/4"	(AX1), (BR1), (DF1), (IN1), (NU2), (R1), (SD2), (SD79), (SP4), DT		
---	---	1	J73	44LHSP270/210	---	-1/2"	59'-2"	-1/4"	F	5"	F	6 1/4"	5"	5"	---	2 1/2"	---	---	59'-1 1/4"	(AX1), (BR1), (DF1), (IN1), (NU2), (R1), (SD2), (SD76), (SD78), (SP4)		
---	---	1	J74	44LHSP270/210	---	-1/2"	59'-2"	-1/4"	F	5"	F	6 1/4"	5"	5"	---	2 1/2"	---	---	59'-1 1/4"	(AX1), (BR1), (DF1), (IN1), (NU2), (R1), (SD2), (SD78), (SP4)		
---	---	2	J75	30KSP270/210	---	-1/4"	48'-0"	-1/4"	F	5 1/4"	F	5 1/4"	5"	2 1/2"	2 1/2"	2 1/2"	---	---	47'-11 1/2"	(BR2), (DF1), (NU1), (SD3), (J-SHL1),		
---	---	2	J76	30KSP270/210	---	-1/4"	48'-0"	-1/4"	F	5 1/4"	F	5 1/4"	5"	2 1/2"	2 1/2"	2 1/2"	---	---	47'-11 1/2"	(BR2), (DF1), (NU1), (SD4), (J-SHL1),		
---	---	1	J77	30KSP270/210	---	-1/4"	48'-0"	-1/4"	F	5 1/4"	F	5 1/4"	5"	2 1/2"	2 1/2"	2 1/2"	---	---	47'-11 1/2"	(BR2), (DF1), (NU1), (P1), (SD5), (SP1), (J-SHL1),		
---	---	1	J78	30KSP270/210	---	-1/4"	48'-0"	-1/4"	F	5 1/4"	F	5 1/4"	5"	2 1/2"	2 1/2"	2 1/2"	---	---	47'-11 1/2"	(BR2), (DF1), (NU1), (P1), (SP1), (J-SHL1),		
---	---	2	J79	30KSP270/210	---	-1/4"	48'-0"	-1/4"	F	5 1/4"	F	5 1/4"	5"	2 1/2"	2 1/2"	2 1/2"	---	---	47'-11 1/2"	(BR2), (DF1), (NU3), (P4), (SD60), (SD61), (J-SHL1),		
---	---	1	J80	30KSP270/210	---	-1/4"	48'-0"	-1/4"	F	5 1/4"	F	5 1/4"	5"	2 1/2"	2 1/2"	2 1/2"	---	---	47'-11 1/2"	(BR2), (DF1), (NU3), (P4), (SD60), (SD61), (SD62), (J-SHL1),		

NOTES:		NET UPLIFT: _____ PLF																			
		ASD <input checked="" type="checkbox"/> LRFID <input type="checkbox"/> FACTORED <input type="checkbox"/>																			
Refer to joist notes list																					
LIMIT JOIST DEFLECTION TO L/240 UNDER LIVE OR SNOW LOAD UNO WITH JOIST																					
NOTE DF1.																					
SEQUENCE	QTY	MARK	TYPE	ELEV. SLOPE	EXTL	C/C OR CLEAR	EXTR	FL / TYPE	CL	FR / TYPE	CR	BDL	BDR	SHL	SHR	BCXL	BCXR	OAL	NOTES		
---	---	---	1 TJ81	30KSP270/210	---	-1/4"	48'-0"	-1/4"	F	5 1/4"	F	5 1/4"	5"	2 1/2"	2 1/2"	7 1/2"	7 1/2"	47'-11 1/2"	(BR2), (DF1), (NU3), (SD63), (J-SHL1), DT		
---	---	---	1 J82	30KSP290/225	---	-1/4"	48'-0"	-1/4"	F	5 1/4"	F	5 1/4"	5"	2 1/2"	2 1/2"	2 1/2"	---	47'-11 1/2"	(BR2), (NU3), (SD64), (J-SHL1),		
---	---	---	146 J83	30KSP290/225	---	-1/4"	48'-0"	-1/4"	F	5 1/4"	F	5 1/4"	5"	2 1/2"	2 1/2"	2 1/2"	---	47'-11 1/2"	(BR2), (NU4), (J-SHL1),		
---	---	---	11 TJ84	30KSP290/225	---	-1/4"	48'-0"	-1/4"	F	5 1/4"	F	5 1/4"	5"	2 1/2"	2 1/2"	2 1/2"	7 1/2"	47'-11 1/2"	(BR2), (NU4), (J-SHL1), DT		
---	---	---	14 J85	30KSP290/225	---	-1/4"	48'-0"	-1/4"	F	5 1/4"	F	5 1/4"	5"	2 1/2"	2 1/2"	2 1/2"	---	47'-11 1/2"	(BR2), (NU4), (SP1), (J-SHL1),		
---	---	---	7 J86	30KSP290/225	---	-1/4"	48'-0"	-1/4"	F	5 1/4"	F	5 1/4"	5"	2 1/2"	2 1/2"	2 1/2"	---	47'-11 1/2"	(BR2), (NU4), (SD53), (J-SHL1),		
---	---	---	6 J87	30KSP290/225	---	-1/4"	48'-0"	-1/4"	F	5 1/4"	F	5 1/4"	5"	2 1/2"	2 1/2"	2 1/2"	---	47'-11 1/2"	(BR2), (NU4), (SD52), (J-SHL1),		
---	---	---	1 J88	30KSP290/225	---	-1/4"	48'-0"	-1/4"	F	5 1/4"	F	5 1/4"	5"	2 1/2"	2 1/2"	2 1/2"	---	47'-11 1/2"	(BR2), (NU4), (SD51), (SP1), (J-SHL1),		
---	---	---	1 J89	30KSP290/225	---	-1/4"	48'-0"	-1/4"	F	5 1/4"	F	5 1/4"	5"	2 1/2"	2 1/2"	2 1/2"	---	47'-11 1/2"	(BR2), (NU4), (P1), (SD53), (SD50), (SP1), (J-SHL1),		
---	---	---	3 TJ90	30KSP290/225	---	-1/4"	48'-0"	-1/4"	F	5 1/4"	F	5 1/4"	5"	2 1/2"	2 1/2"	2 1/2"	7 1/2"	47'-11 1/2"	(BR2), (NU4), (P1), (SD53), (SD50), (J-SHL1), DT		
---	---	---	7 J91	30KSP290/225	---	-1/4"	48'-0"	-1/4"	F	5 1/4"	F	5 1/4"	5"	2 1/2"	2 1/2"	2 1/2"	---	47'-11 1/2"	(BR2), (NU4), (SD51), (J-SHL1),		
---	---	---	2 J98	30KSP340/225	---	-1/4"	48'-0"	-1/4"	F	5 1/4"	F	5 1/4"	5"	2 1/2"	2 1/2"	2 1/2"	---	47'-11 1/2"	(BR2), (NU4), (SP1), (J-SHL1),		
---	---	---	1 J99	30KSP290/225	---	-1/4"	48'-0"	-1/4"	F	5 1/4"	F	5 1/4"	5"	2 1/2"	2 1/2"	2 1/2"	---	47'-11 1/2"	(BR2), (NU4), (SD53), (SP1), (J-SHL1),		
---	---	---	1 J100	30KSP290/225	---	-1/4"	48'-0"	-1/4"	F	5 1/4"	F	5 1/4"	5"	2 1/2"	2 1/2"	2 1/2"	---	47'-11 1/2"	(BR2), (NU3), (J-SHL1),		

NOTES:		NET UPLIFT: _____ PLF																			
		ASD <input checked="" type="checkbox"/> LRFD <input type="checkbox"/> FACTORED <input type="checkbox"/>																			
Refer to joist notes list																					
LIMIT JOIST DEFLECTION TO L/240 UNDER LIVE OR SNOW LOAD UNO WITH JOIST																					
NOTE DF1.																					
SEQUENCE		QTY	MARK	TYPE	ELEV. SLOPE	EXTL	C/C OR CLEAR	EXTR	FL / TYPE	CL	FR / TYPE	CR	BDL	BDR	SHL	SHR	BCXL	BCXR	OAL	NOTES	
---	---	---	---	---	---	---	---	---	---	---	---	---	---	---	---	---	---	---	---		
---	---	---	1	TJ101	30KSP270/210	---	-1/4"	48'-0"	-1/4"	F	5 1/4"	F	5 1/4"	5"	2 1/2"	2 1/2"	2 1/2"	7 1/2"	7 1/2"	47'-11 1/2" (BR2), (DF1), (NU3), (J-SHL1), DT	
---	---	---	3	J102	30KSP270/210	---	-1/4"	48'-0"	-1/4"	F	5 1/4"	F	5 1/4"	5"	2 1/2"	2 1/2"	2 1/2"	---	---	47'-11 1/2" (BR2), (DF1), (NU3), (J-SHL1)	
---	---	---	1	J103	30KSP270/210	---	-1/4"	48'-0"	-1/4"	F	5 1/4"	F	5 1/4"	5"	2 1/2"	2 1/2"	2 1/2"	---	---	47'-11 1/2" (BR2), (DF1), (NU1), (SP1), (J-SHL1)	
---	---	---	1	J104	30KSP270/210	---	-1/4"	48'-0"	-1/4"	F	5 1/4"	F	5 1/4"	5"	2 1/2"	2 1/2"	2 1/2"	---	---	47'-11 1/2" (BR2), (DF1), (NU1), (SD5), (SP1), (J-SHL1)	
---	---	---	4	J105	30KSP270/210	---	-1/4"	48'-0"	-1/4"	F	5 1/4"	F	5 1/4"	2 1/2"	2 1/2"	2 1/2"	2 1/2"	---	---	47'-11 1/2" (BR2), (DF1), (NU1), (SD3)	
---	---	---	513	J112	30KSP290/225	---	-1/4"	48'-0"	-1/4"	F	5 1/4"	F	5 1/4"	2 1/2"	2 1/2"	2 1/2"	2 1/2"	---	---	47'-11 1/2" (BR2), (NU4)	
---	---	---	57	TJ113	30KSP290/225	---	-1/4"	48'-0"	-1/4"	F	5 1/4"	F	5 1/4"	2 1/2"	2 1/2"	2 1/2"	2 1/2"	7 1/2"	7 1/2"	47'-11 1/2" (BR2), (NU4), DT	
---	---	---	51	J114	30KSP290/225	---	-1/4"	48'-0"	-1/4"	F	5 1/4"	F	5 1/4"	2 1/2"	2 1/2"	2 1/2"	2 1/2"	---	---	47'-11 1/2" (BR2), (NU4), (SP1)	
---	---	---	48	J115	30KSP340/225	---	-1/4"	48'-0"	-1/4"	F	5 1/4"	F	5 1/4"	2 1/2"	2 1/2"	2 1/2"	2 1/2"	---	---	47'-11 1/2" (BR2), (NU4)	
---	---	---	6	TJ116	30KSP300/225	---	48'-0"	48'-0"	48'-0"	---	---	---	---	---	---	---	---	48'-0"	48'-0"	47'-11 1/2" (BR2), (NU4), DT	
---	---	---	3	TJ117	30KSP290/225	---	-1/4"	48'-0"	-1/4"	F	5 1/4"	F	5 1/4"	2 1/2"	2 1/2"	2 1/2"	2 1/2"	7 1/2"	7 1/2"	47'-11 1/2" (BR2), (NU4), (SP1), DT	
---	---	---	6	J118	30KSP340/225	---	-1/4"	48'-0"	-1/4"	F	5 1/4"	F	5 1/4"	2 1/2"	2 1/2"	2 1/2"	2 1/2"	---	---	47'-11 1/2" (BR2), (NU4), (SP1)	
---	---	---	1	J119	30KSP270/210	---	-1/4"	48'-0"	-1/4"	F	5 1/4"	F	5 1/4"	2 1/2"	2 1/2"	2 1/2"	2 1/2"	---	---	47'-11 1/2" (BR2), (DF1), (NU3), (SD82)	
---	---	---	1	J120	30KSP270/210	---	-1/4"	48'-0"	-1/4"	F	5 1/4"	F	5 1/4"	2 1/2"	2 1/2"	2 1/2"	2 1/2"	---	---	47'-11 1/2" (BR2), (DF1), (NU3), (SD81)	

NOTES:		NET UPLIFT: _____ PLF																			
		ASD <input checked="" type="checkbox"/> LRFD <input type="checkbox"/> FACTORED <input type="checkbox"/>																			
Refer to joist notes list																					
LIMIT JOIST DEFLECTION TO L/240 UNDER LIVE OR SNOW LOAD UNO WITH JOIST																					
NOTE DF1.																					
SEQUENCE	QTY	MARK	TYPE	ELEV. SLOPE	EXTL	C/C OR CLEAR	EXTR	FL / TYPE	CL	FR / TYPE	CR	BDL	BDR	SHL	SHR	BCXL	BCXR	OAL	NOTES		
---	---	---	---	---	---	---	---	---	---	---	---	---	---	---	---	---	---	---			
---	---	1	J121	30KSP270/210	---	-1/4"	48'-0"	-1/4"	F	5 1/4"	F	5 1/4"	2 1/2"	2 1/2"	2 1/2"	2 1/2"	---	---	47'-11 1/2"	(BR2), (DF1), (NU3), (P1), (SD44), (SD45), (SD80)	
---	---	1	J122	30KSP270/210	---	-1/4"	48'-0"	-1/4"	F	5 1/4"	F	5 1/4"	2 1/2"	2 1/2"	2 1/2"	2 1/2"	---	---	47'-11 1/2"	(BR2), (DF1), (NU1), (P1), (SD44), (SD45), (SD80), (SP1)	
---	---	1	J123	30KSP270/210	---	-1/4"	48'-0"	-1/4"	F	5 1/4"	F	5 1/4"	2 1/2"	2 1/2"	2 1/2"	2 1/2"	---	---	47'-11 1/2"	(BR2), (DF1), (NU1), (P2), (SD5), (SP1)	
---	---	1	J124	30KSP270/210	---	-1/4"	48'-0"	-1/4"	F	5 1/4"	F	5 1/4"	2 1/2"	2 1/2"	2 1/2"	2 1/2"	---	---	47'-11 1/2"	(BR2), (DF1), (NU1), (P2), (SP1)	
---	---	1	TJ125	30KSP270/210	---	-1/4"	48'-0"	-1/4"	F	5 1/4"	F	5 1/4"	2 1/2"	2 1/2"	2 1/2"	2 1/2"	7 1/2"	7 1/2"	47'-11 1/2"	(BR2), (DF1), (NU3), (SD85), DT	
---	---	2	J138	30KSP270/210	---	-1/4"	48'-0"	-1"	F	5 1/4"	F	6"	2 1/2"	5"	2 1/2"	2 1/2"	---	---	47'-10 3/4"	(BR2), (NU1), (PL1), (SD5), (SP1), (J-SHR1)	
---	---	2	J139	30KSP270/210	---	-1/4"	48'-0"	-1"	F	5 1/4"	F	6"	2 1/2"	5"	2 1/2"	2 1/2"	---	---	47'-10 3/4"	(BR2), (NU1), (PL1), (SP1), (J-SHR1)	
---	---	6	J140	30KSP270/210	---	-1/4"	48'-0"	-1"	F	5 1/4"	F	6"	2 1/2"	5"	2 1/2"	2 1/2"	---	---	47'-10 3/4"	(BR2), (NU3), (PL1), (J-SHR1)	

NOTES:	NET UPLIFT: _____ PLF																														
	ASD <input checked="" type="checkbox"/>	LRFD <input type="checkbox"/>	FACTORED <input type="checkbox"/>																												
Refer to joist notes list																															
LIMIT JOIST DEFLECTION TO L/240 UNDER LIVE OR SNOW LOAD UNO WITH JOIST																															
NOTE DF1.																															
SEQUENCE	QTY	MARK	TYPE	ELEV. SLOPE	EXTL	C/C OR CLEAR	EXTR	FL / TYPE	CL	FR / TYPE	CR	BDL	BDR	SHL	SHR	BCXL	BCXR	OAL	NOTES												
---	---	---	---	---	---	---	---	---	---	---	---	---	---	---	---	---	---	---													
---	---	2	TJ141	30KSP270/210	---	-1/4"	48'-0"	-1"	F	5 1/4"	F	6"	2 1/2"	5"	2 1/2"	2 1/2"	7 1/2"	7 1/2"	47'-10 3/4"	(BR2), (NU3), (PL1), (J-SHR1), DT											
---	---	2	J142	30KSP290/225	---	-1/4"	48'-0"	-1"	F	5 1/4"	F	6"	2 1/2"	5"	2 1/2"	2 1/2"	---	---	47'-10 3/4"	(BR2), (NU3), (PL1), (J-SHR1)											
---	---	171	J143	30KSP290/225	---	-1/4"	48'-0"	-1"	F	5 1/4"	F	6"	2 1/2"	5"	2 1/2"	2 1/2"	---	---	47'-10 3/4"	(BR2), (NU4), (PL1), (J-SHR1)											
---	---	21	TJ144	30KSP290/225	---	-1/4"	48'-0"	-1"	F	5 1/4"	F	6"	2 1/2"	5"	2 1/2"	2 1/2"	7 1/2"	7 1/2"	47'-10 3/4"	(BR2), (NU4), (PL1), (J-SHR1), DT											
---	---	17	J145	30KSP290/225	---	-1/4"	48'-0"	-1"	F	5 1/4"	F	6"	2 1/2"	5"	2 1/2"	2 1/2"	---	---	47'-10 3/4"	(BR2), (NU4), (PL1), (SP1), (J-SHR1)											
---	---	16	J146	30KSP340/225	---	-1/4"	48'-0"	-1"	F	5 1/4"	F	6"	2 1/2"	5"	2 1/2"	2 1/2"	---	---	47'-10 3/4"	(BR2), (NU4), (PL1), (J-SHR1)											
---	1	TJ147	30KSP290/225	---	-1/4"	48'-0"	-1"	F	5 1/4"	F	6"	2 1/2"	5"	2 1/2"	2 1/2"	7 1/2"	7 1/2"	47'-10 3/4"	(BR2), (NU4), (PL1), (SP1), (J-SHR1), DT												
---	2	J148	30KSP340/225	---	-1/4"	48'-0"	-1"	F	5 1/4"	F	6"	2 1/2"	5"	2 1/2"	2 1/2"	---	---	47'-10 3/4"	(BR2), (NU4), (PL1), (SP1), (J-SHR1)												
---	2	J149	30KSP270/210	---	-1/4"	48'-0"	-1"	F	5 1/4"	F	9"	2 1/2"	5"	2 1/2"	5 1/2"	---	---	47'-10 3/4"	(BR3), (NU1), (PL2), (SD3), (J-SHR1)												
---	2	J150	30KSP270/210	---	-1/4"	48'-0"	-1"	F	5 1/4"	F	9"	2 1/2"	5"	2 1/2"	5 1/2"	---	---	47'-10 3/4"	(BR3), (NU1), (PL2), (SD4), (J-SHR1)												
---	2	J151	30KSP270/210	---	-1/4"	48'-0"	-1"	F	5 1/4"	F	9"	2 1/2"	5"	2 1/2"	5 1/2"	---	---	47'-10 3/4"	(BR3), (NU1), (PL2), (SD5), (SP1), (J-SHR1)												
---	2	J152	30KSP270/210	---	-1/4"	48'-0"	-1"	F	5 1/4"	F	9"	2 1/2"	5"	2 1/2"	5 1/2"	---	---	47'-10 3/4"	(BR3), (NU1), (PL2), (SP1), (J-SHR1)												
---	6	J153	30KSP270/210	---	-1/4"	48'-0"	-1"	F	5 1/4"	F	9"	2 1/2"	5"	2 1/2"	5 1/2"	---	---	47'-10 3/4"	(BR3), (NU3), (PL2), (J-SHR1)												
---	1	TJ154	30KSP270/210	---	-1/4"	48'-0"	-1"	F	5 1/4"	F	9"	2 1/2"	5"	2 1/2"	5 1/2"	7 1/2"	9"	47'-10 3/4"	(BR3), (NU3), (PL2), (J-SHR1), DT												
---	2	J155	30KSP290/225	---	-1/4"	48'-0"	-1"	F	5 1/4"	F	9"	2 1/2"	5"	2 1/2"	5 1/2"	---	---	47'-10 3/4"	(BR3), (NU3), (PL2), (J-SHR1)												
---	171	J156	30KSP290/225	---	-1/4"	48'-0"	-1"	F	5 1/4"	F	9"	2 1/2"	5"	2 1/2"	5 1/2"	---	---	47'-10 3/4"	(BR3), (NU4), (PL2), (J-SHR1)												
---	18	TJ157	30KSP290/225	---	-1/4"	48'-0"	-1"	F	5 1/4"	F	9"	2 1/2"	5"	2 1/2"	5 1/2"	7 1/2"	9"	47'-10 3/4"	(BR3), (NU4), (PL2), (J-SHR1), DT												
---	17	J158	30KSP290/225	---	-1/4"	48'-0"	-1"	F	5 1/4"	F	9"	2 1/2"	5"	2 1/2"	5 1/2"	---	---	47'-10 3/4"	(BR3), (NU4), (PL2), (SP1), (J-SHR1)												
---	16	J159	30KSP340/225	---	-1/4"	48'-0"	-1"	F	5 1/4"	F	9"	2 1/2"	5"	2 1/2"	5 1/2"	---	---	47'-10 3/4"	(BR3), (NU4), (PL2), (J-SHR1)												
---	1	TJ160	30KSP290/225	---	-1/4"	48'-0"	-1"	F	5 1/4"	F	9"	2 1/2"	5"	2 1/2"	5 1/2"	7 1/2"	9"	47'-10 3/4"	(BR3), (NU4), (PL2), (SP1), (J-SHR1), DT												

NOTES:		NET UPLIFT: _____ PLF																				
		ASD <input checked="" type="checkbox"/> LRFD <input type="checkbox"/> FACTORED <input type="checkbox"/>																				
Refer to joist notes list																						
LIMIT JOIST DEFLECTION TO L/240 UNDER LIVE OR SNOW LOAD UND WITH JOIST																						
NOTE DF1.																						
SEQUENCE		QTY	MARK	TYPE	ELEV. SLOPE	EXTL	C/C OR CLEAR	EXTR	FL / TYPE	CL	FR / TYPE	CR	BDL	BDR	SHL	SHR	BCXL	BCXR	OAL	NOTES		
---	---	---	---	---	---	---	---	---	---	---	---	---	---	---	---	---	---	---	---	---	---	
---	---	---	2	J161	30KSP340/225	---	-1/4"	48'-0"	-1"	F	5 1/4"	F	9"	2 1/2"	5"	2 1/2"	5 1/2"	---	---	47'-10 3/4"	(BR3), (NU4), (PL2), (SP1), (J-SHR1)	
---	---	---	3	TJ162	30KSP290/225	---	-1/4"	48'-0"	-1"	F	5 1/4"	F	6"	2 1/2"	5"	2 1/2"	2 1/2"	7 1/2"	7 1/2"	47'-10 3/4"	(BR3), (NU4), (PL2), (J-SHR1), DT	
---	---	---	1	TJ163	30KSP270/210	---	-1/4"	48'-0"	-1"	F	5 1/4"	F	6"	2 1/2"	5"	2 1/2"	2 1/2"	7 1/2"	7 1/2"	47'-10 3/4"	(BR3), (NU3), (PL2), (J-SHR1), DT	
---	---	---	4	J164	30KSP270/210	---	-1/4"	48'-0"	-1/4"	F	5 1/4"	F	5 1/4"	2 1/2"	2 1/2"	2 1/2"	2 1/2"	---	---	47'-11 1/2"	(BR3), (NU1), (SD3)	
---	---	---	4	J165	30KSP270/210	---	-1/4"	48'-0"	-1/4"	F	5 1/4"	F	5 1/4"	2 1/2"	2 1/2"	2 1/2"	2 1/2"	---	---	47'-11 1/2"	(BR3), (NU1), (SD4)	
---	---	---	3	J166	30KSP270/210	---	-1/4"	48'-0"	-1/4"	F	5 1/4"	F	5 1/4"	2 1/2"	2 1/2"	2 1/2"	2 1/2"	---	---	47'-11 1/2"	(BR3), (NU1), (SD5), (SP1)	
---	---	---	3	J167	30KSP270/210	---	-1/4"	48'-0"	-1/4"	F	5 1/4"	F	5 1/4"	2 1/2"	2 1/2"	2 1/2"	2 1/2"	---	---	47'-11 1/2"	(BR3), (NU1), (SP1)	
---	---	---	12	J168	30KSP270/210	---	-1/4"	48'-0"	-1/4"	F	5 1/4"	F	5 1/4"	2 1/2"	2 1/2"	2 1/2"	2 1/2"	---	---	47'-11 1/2"	(BR3), (NU3)	
---	---	---	4	TJ169	30KSP270/210	---	-1/4"	48'-0"	-1/4"	F	5 1/4"	F	5 1/4"	2 1/2"	2 1/2"	2 1/2"	2 1/2"	7 1/2"	7 1/2"	47'-11 1/2"	(BR3), (NU3), DT	
---	---	---	4	J170	30KSP290/225	---	-1/4"	48'-0"	-1/4"	F	5 1/4"	F	5 1/4"	2 1/2"	2 1/2"	2 1/2"	2 1/2"	---	---	47'-11 1/2"	(BR3), (NU3)	
---	---	---	1	J177	30KSP270/210	---	-1/4"	48'-0"	-1/4"	F	5 1/4"	F	5 1/4"	2 1/2"	2 1/2"	2 1/2"	2 1/2"	---	---	47'-11 1/2"	(BR3), (NU1), (P2), (SP1)	
---	---	---	1	J178	30KSP270/210	---	-1/4"	48'-0"	-1/4"	F	5 1/4"	F	5 1/4"	2 1/2"	2 1/2"	2 1/2"	2 1/2"	---	---	47'-11 1/2"	(BR3), (NU1), (P2), (SD5), (SP1)	
---	---	---	1	J179	30KSP290/225	---	-1/4"	48'-0"	-1/4"	F	5 1/4"	F	5 1/4"	2 1/2"	2 1/2"	2 1/2"	2 1/2"	---	---	47'-11 1/2"	(BR3), (DF1), (NU3), (SD88)	
---	---	---	1	TJ180	30KSP270/210	---	-1/4"	48'-0"	-1/4"	F	5 1/4"	F	5 1/4"	2 1/2"	2 1/2"	2 1/2"	2 1/2"	7 1/2"	7 1/2"	47'-11 1/2"	(BR3), (DF1), (NU3), (SD87), DT	

NOTES:		NET UPLIFT: <input type="text"/> PLF																			
		ASD <input checked="" type="checkbox"/> LRFID <input type="checkbox"/> FACTORED <input type="checkbox"/>																			
Refer to joist notes list																					
LIMIT JOIST DEFLECTION TO L/240 UNDER LIVE OR SNOW LOAD UNO WITH JOIST																					
NOTE DF1.																					
SEQUENCE	QTY	MARK	TYPE	ELEV. SLOPE	EXTL	C/C OR CLEAR	EXTR	FL / TYPE	CL	FR / TYPE	CR	BDL	BDR	SHL	SHR	BCXL	BCXR	OAL	NOTES		
---	---	---	---	---	---	---	---	---	---	---	---	---	---	---	---	---	---	---	---		
---	---	2	J181	30KSP270/210	---	-1/4"	48'-0"	-1/4"	F	5 1/4"	F	5 1/4"	2 1/2"	2 1/2"	2 1/2"	2 1/2"	---	---	47'-11 1/2"	(BR3), (DF1), (NU3), (P1), (SD30), (SD31), (SD86)	
---	---	4	J182	30KSP270/210	---	-1/4"	48'-0"	-1/4"	F	5 1/4"	F	5 1/4"	2 1/2"	2 1/2"	2 1/2"	2 1/2"	---	---	47'-11 1/2"	(BR3), (DF1), (NU3)	
---	---	2	J183	30KSP270/210	---	-1/4"	48'-0"	-1/4"	F	5 1/4"	F	5 1/4"	2 1/2"	2 1/2"	2 1/2"	2 1/2"	---	---	47'-11 1/2"	(BR3), (DF1), (NU1), (SP1)	
---	---	2	J184	30KSP270/210	---	-1/4"	48'-0"	-1/4"	F	5 1/4"	F	5 1/4"	2 1/2"	2 1/2"	2 1/2"	2 1/2"	---	---	47'-11 1/2"	(BR3), (DF1), (NU1), (SD5), (SP1)	
---	---	2	J185	30KSP270/210	---	-1/4"	48'-0"	-1/4"	F	5 1/4"	F	5 1/4"	2 1/2"	2 1/2"	2 1/2"	2 1/2"	---	---	47'-11 1/2"	(BR3), (DF1), (NU1), (SD4)	
---	---	2	J186	30KSP270/210	---	-1/4"	48'-0"	-1/4"	F	5 1/4"	F	5 1/4"	2 1/2"	2 1/2"	2 1/2"	2 1/2"	---	---	47'-11 1/2"	(BR3), (DF1), (NU1), (SD3)	
---	---	1	J187	30KSP290/225	---	-1/4"	48'-0"	-1/4"	F	5 1/4"	F	5 1/4"	2 1/2"	2 1/2"	2 1/2"	2 1/2"	---	---	47'-11 1/2"	(BR3), (DF1), (NU3)	
---	---	1	TJ188	30KSP270/210	---	-1/4"	48'-0"	-1/4"	F	5 1/4"	F	5 1/4"	2 1/2"	2 1/2"	2 1/2"	2 1/2"	7 1/2"	7 1/2"	47'-11 1/2"	(BR3), (DF1), (NU3), DT	
---	---	1	J189	30KSP270/210	---	-1/4"	48'-0"	-1/4"	F	5 1/4"	F	5 1/4"	5"	2 1/2"	2 1/2"	2 1/2"	---	---	47'-11 1/2"	(BR3), (NU1), (SD3), (J-SHL1)	
---	146	J196	30KSP290/225	---	-1/4"	48'-0"	-1/4"	F	5 1/4"	F	5 1/4"	5"	2 1/2"	2 1/2"	2 1/2"	---	---	47'-11 1/2"	(BR3), (NU4), (J-SHL1)		
---	17	TJ197	30KSP290/225	---	-1/4"	48'-0"	-1/4"	F	5 1/4"	F	5 1/4"	5"	2 1/2"	2 1/2"	2 1/2"	7 1/2"	7 1/2"	47'-11 1/2"	(BR3), (NU4), (J-SHL1), , DT		
---	14	J198	30KSP290/225	---	-1/4"	48'-0"	-1/4"	F	5 1/4"	F	5 1/4"	5"	2 1/2"	2 1/2"	2 1/2"	---	---	47'-11 1/2"	(BR3), (NU4), (SP1), (J-SHL1)		
---	7	J199	30KSP290/225	---	-1/4"	48'-0"	-1/4"	F	5 1/4"	F	5 1/4"	5"	2 1/2"	2 1/2"	2 1/2"	---	---	47'-11 1/2"	(BR3), (NU4), (SD53), (J-SHL1)		
---	2	J200	30KSP290/225	---	-1/4"	48'-0"	-1/4"	F	5 1/4"	F	5 1/4"	5"	2 1/2"	2 1/2"	2 1/2"	---	---	47'-11 1/2"	(BR3), (NU4), (SD48), (J-SHL1)		

NOTES:		NET UPLIFT: _____ PLF																			
		ASD <input checked="" type="checkbox"/> LRFID <input type="checkbox"/> FACTORED <input type="checkbox"/>																			
Refer to joist notes list																					
LIMIT JOIST DEFLECTION TO L/240 UNDER LIVE OR SNOW LOAD UNO WITH JOIST																					
NOTE DF1.																					
SEQUENCE	QTY	MARK	TYPE	ELEV. SLOPE	EXTL	C/C OR CLEAR	EXTR	FL / TYPE	CL	FR / TYPE	CR	BDL	BDR	SHL	SHR	BCXL	BCXR	OAL	NOTES		
---	---	---	---	---	---	---	---	---	---	---	---	---	---	---	---	---	---	---	---		
---	---	1	J201	30KSP290/225	---	-1/4"	48'-0"	-1/4"	F	5 1/4"	F	5 1/4"	5"	2 1/2"	2 1/2"	2 1/2"	---	---	47'-11 1/2"	(BR3), (NU4), (SD51), (SP1), (J-SHL1),	
---	---	1	J202	30KSP290/225	---	-1/4"	48'-0"	-1/4"	F	5 1/4"	F	5 1/4"	5"	2 1/2"	2 1/2"	2 1/2"	---	---	47'-11 1/2"	(BR3), (NU4), (P1), (SD33), (SD50), (SP1), (J-SHL1),	
---	---	4	TJ203	30KSP290/225	---	-1/4"	48'-0"	-1/4"	F	5 1/4"	F	5 1/4"	5"	2 1/2"	2 1/2"	2 1/2"	7 1/2"	7 1/2"	47'-11 1/2"	(BR3), (NU4), (P1), (SD33), (SD50), (J-SHL1), DT	
---	---	7	J204	30KSP290/225	---	-1/4"	48'-0"	-1/4"	F	5 1/4"	F	5 1/4"	5"	2 1/2"	2 1/2"	2 1/2"	---	---	47'-11 1/2"	(BR3), (NU4), (SD51), (J-SHL1),	
---	---	16	J205	30KSP340/225	---	-1/4"	48'-0"	-1/4"	F	5 1/4"	F	5 1/4"	5"	2 1/2"	2 1/2"	2 1/2"	---	---	47'-11 1/2"	(BR3), (NU4), (J-SHL1),	
---	---	6	J206	30KSP290/225	---	-1/4"	48'-0"	-1/4"	F	5 1/4"	F	5 1/4"	5"	2 1/2"	2 1/2"	2 1/2"	---	---	47'-11 1/2"	(BR3), (NU4), (SD52), (J-SHL1),	
---	---	3	J207	30KSP290/225	---	-1/4"	48'-0"	-1/4"	F	5 1/4"	F	5 1/4"	5"	2 1/2"	2 1/2"	2 1/2"	---	---	47'-11 1/2"	(BR3), (NU4), (P1), (SD33), (SD50), (J-SHL1),	
---	---	1	TJ208	30KSP290/225	---	-1/4"	48'-0"	-1/4"	F	5 1/4"	F	5 1/4"	5"	2 1/2"	2 1/2"	2 1/2"	7 1/2"	7 1/2"	47'-11 1/2"	(BR3), (NU4), (SP1), (J-SHL1), DT	
---	---	2	J209	30KSP340/225	---	-1/4"	48'-0"	-1/4"	F	5 1/4"	F	5 1/4"	5"	2 1/2"	2 1/2"	2 1/2"	---	---	47'-11 1/2"	(BR3), (NU4), (SP1), (J-SHL1),	
---	---	1	J216	30KSP270/210	---	-1/4"	48'-0"	-1/4"	F	5 1/4"	F	5 1/4"	5"	2 1/2"	2 1/2"	2 1/2"	---	---	47'-11 1/2"	(BR3), (DF1), (NU1), (P1), (SD26), (SD27), (SD89), (SP1), (J-SHL1),	
---	---	1	J217	30KSP270/210	---	-1/4"	48'-0"	-1/4"	F	5 1/4"	F	5 1/4"	5"	2 1/2"	2 1/2"	2 1/2"	---	---	47'-11 1/2"	(BR3), (DF1), (NU1), (P1), (SD4), (SD26), (SD27), (SD89), (J-SHL1),	
---	---	1	J218	30KSP270/210	---	-1/4"	48'-0"	-1/4"	F	5 1/4"	F	5 1/4"	5"	2 1/2"	2 1/2"	2 1/2"	---	---	47'-11 1/2"	(BR3), (DF1), (NU1), (SD3), (J-SHL1),	
---	---	1	J219	44LHSP270/210	---	-1/2"	59'-2"	-1/4"	F	5"	F	6 1/4"	5"	5"	---	2 1/2"	---	---	59'-1 1/4"	(AX1), (BR1), (IN1), (NU1), (R1), (SD3), (SD6)	
---	---	1	J220	44LHSP270/210	---	-1/2"	59'-2"	-1/4"	F	5"	F	6 1/4"	5"	5"	---	2 1/2"	---	---	59'-1 1/4"	(AX1), (BR1), (IN1), (NU1), (R1), (SD4), (SD7)	

NOTES:		NET UPLIFT: <input type="text"/> PLF																			
		ASD <input checked="" type="checkbox"/> LRFD <input type="checkbox"/> FACTORED <input type="checkbox"/>																			
Refer to joist notes list																					
LIMIT JOIST DEFLECTION TO L/240 UNDER LIVE OR SNOW LOAD UNO WITH JOIST																					
NOTE DF1.																					
SEQUENCE	QTY	MARK	TYPE	ELEV. SLOPE	EXTL	C/C OR CLEAR	EXTR	FL / TYPE	CL	FR / TYPE	CR	BDL	BDR	SHL	SHR	BCXL	BCXR	OAL	NOTES		
---	---	2	J221	44LHSP270/210	---	-1/2"	59'-2"	-1/4"	F	5"	F	6 1/4"	5"	5"	---	2 1/2"	---	---	59'-1 1/4"	(AX1), (BR1), (IN1), (NU2), (R1), (SD2), (SP4)	
---	---	1	TJ222	44LHSP270/210	---	-1/2"	59'-2"	-1/4"	F	5"	F	6 1/4"	5"	5"	---	2 1/2"	---	7 1/2"	59'-1 1/4"	(AX1), (BR1), (IN1), (NU2), (R1), (SD2), (SP4), DT	
---	---	1	J223	44LHSP290/225	---	-1/2"	59'-2"	-1/4"	F	5"	F	6 1/4"	5"	5"	---	2 1/2"	---	---	59'-1 1/4"	(AX1), (BR1), (IN1), (NU2), (R1), (SD1), (SD47), (SP1), (SP5)	
---	---	1	J224	44LHSP290/225	---	-1/2"	59'-2"	-1/4"	F	5"	F	6 1/4"	5"	5"	---	2 1/2"	---	---	59'-1 1/4"	(AX1), (BR1), (IN1), (NU2), (P1), (R1), (SD1), (SD32), (SD46), (SP1), (SP5)	
---	---	1	TJ225	44LHSP290/225	---	-1/2"	59'-2"	-1/4"	F	5"	F	6 1/4"	5"	5"	---	2 1/2"	---	7 1/2"	59'-1 1/4"	(AX1), (BR1), (IN1), (NU2), (P1), (R1), (SD1), (SD32), (SD46), (SP1), (SP5), DT	
---	---	1	J226	44LHSP290/225	---	-1/2"	59'-2"	-1/4"	F	5"	F	6 1/4"	5"	5"	---	2 1/2"	---	---	59'-1 1/4"	(AX1), (BR1), (IN1), (NU2), (R1), (SD1), (SD47), (SP1), (SP5)	
---	---	1	J227	44LHSP290/225	---	-1/2"	59'-2"	-1/4"	F	5"	F	6 1/4"	5"	5"	---	2 1/2"	---	---	59'-1 1/4"	(AX1), (BR1), (IN1), (NU2), (R1), (SD1), (SD48), (SP1), (SP5)	
---	---	1	J228	44LHSP290/225	---	-1/2"	59'-2"	-1/4"	F	5"	F	6 1/4"	5"	5"	---	2 1/2"	---	---	59'-1 1/4"	(AX1), (BR1), (IN1), (NU2), (R1), (SD1), (SD49), (SP1), (SP5)	
---	---	1	J240	44LHSP270/210	---	-1/2"	60'-0"	-1/4"	F	5"	F	6 1/4"	5"	5"	---	2 1/2"	---	---	59'-11 1/4"	(AX1), (BR1), (DF1), (IN1), (NU1), (P1), (R1), (SD9), (SD24), (SD46), (SP1), (SP4)	

NOTE	DESCRIPTION	NOTE	DESCRIPTION
AX1	DESIGN ALL JOIST ENDS AND TC FOR AXIAL FORCE OF 4.0K (1.0 WIND) AND 7.5K (1.0 SEISMIC) FOR JOISTS BETWEEN GRIDLINE A&B AND M&N	SD13	244PLF ADD'L SNOW DRIFT @ 32'-7 1/2" FROM TE TO 0PLF (17'-0") TOWARDS NTE
BR1	SEE PROFILE #1 ON SHT JE3.02 FOR JOIST BRIDGING PROFILE	SD16	244PLF ADD'L SNOW DRIFT @ 44'-1" FROM TE TO 0 PLF(17'-0") TOWARDS TE
BR2	SEE PROFILE #2 ON SHT JE3.02 FOR JOIST BRIDGING PROFILE	SD17	244PLF ADD'L SNOW DRIFT @ 50'-5" FROM TE TO 0PLF (17'-0") TOWARDS NTE
BR3	SEE PROFILE #3 ON SHT JE3.02 FOR JOIST BRIDGING PROFILE	SD18	244PLF ADD'L SNOW DRIFT @ 23'-10 1/2" FROM TE TO 0 PLF(17'-0") TOWARDS TE
DF1	LIMIT JOIST GIRDER DEFLECTION TO L/360 UNDER LIVE OR SNOW LOAD		
IN1	DESIGN JOIST FOR MIN. MOMENT OF INERTIA OF 1,450IN^4	SD19	244PLF ADD'L SNOW DRIFT @ 30'-3" FROM TE TO 0PLF (17'-0") TOWARDS NTE
NU1	NU= -169PLF	SD20	244PLF ADD'L SNOW DRIFT @ 44'-10 1/2" FROM TE TO 0PLF (17'-0") TOWARDS TE
NU2	NU= -169 PLF @ 1ST 26'-9" FROM TE, -113PLF @ BALANCE		
NU3	NU= -113PLF	SD21	244PLF ADD'L SNOW DRIFT @ 51'-3" FROM TE TO 0 PLF (17'-0") TOWARDS NTE
NU4	NU= -66PLF	SD22	244PLF ADD'L SNOW DRIFT @ 14'-4" FROM TE TO 0PLF (17'-0") TOWARDS TE
P1	(2) +0.4K (+0.8K TOTAL) ANYWHERE ALONG TC	SD23	244PLF ADD'L SNOW DRIFT @ 20'-8 1/4" FROM TE TO 0PLF (17'-0") TOWARDS NTE
P2	(2) +0.5K (+1.0K TOTAL) ANYWHERE ALONG TC		
P3	(4) +0.4K (+1.6K TOTAL) ANYWHERE ALONG TC	SD24	244PLF ADD'L SNOW DRIFT @ 35'-10" FROM NTE TO 0PLF (17'-0") TOWARDS NTE
P4	(2) +0.3K (+0.6K TOTAL) ANYWHERE ALONG TC		
PL1	'SPEED BAY' BEARING PLATE FIXED SIDE	SD26	244PLF ADD'L SNOW DRIFT @ 7'-7 3/8" FROM TE TO 0PLF (17'-0") TOWARDS TE
PL2	'SPEED BAY' BEARING PLATE SLIDE SIDE (13/16"x5" LONG SLOTS FOR TEMP EXPANSION JOINT FIN/	SD27	244PLF ADD'L SNOW DRIFT @ 13'-11 5/8" FROM TE TO 0PLF (17'-0") TOWARDS NTE
R1	DESIGN JOIST SEATS FOR 3.25K ROLLOVER (1.0 WIND) & 2.0K (1.0 SEISMIC)		NTE
SD1	261PLF SNOW DRIFT @ TE TO 0PLF, 17'-0" FROM TE	SD28	244PLF ADD'L SNOW DRIFT @ 17'-2 1/4 FROM TE TO 0PLF (17'-0") TOWARDS TE
SD2	247PLF SNOW DRIFT @ TE TO 0PLF, 17'-0" FROM TE	SD29	244PLF ADD'L SNOW DRIFT @ 23'-6 1/2" FROM TE TO 0PLF (17'-0") TOWARDS NTE
SD3	162PLF SNOW DRIFT ALONG TC		NTE
SD4	78PLF SNOW DRIFT ALONG TC	SD30	244PLF ADD'L SNOW DRIFT @ 16'-9" FROM TE TO 0PLF (17'-0") TOWARDS TE
SD5	12PLF SNOW DRIFT ALONG TC	SD31	244PLF ADD'L SNOW DRIFT @ 23'-1 1/2" FROM TE TO 0PLF (17'-0") TOWARDS NTE
SD6	87PLF ADD'L SNOW DRIFT @ TE TO 0PLF, 5'10" FROM TE		NTE
SD7	173PLF ADD'L SNOW DRIFT @ TE TO 0PLF, 11'-9" FROM TE	SD32	261PLF ADD'L SNOW DRIFT @ 56'-10 1/4" FROM NTE TO 0PLF (17'-0") TOWARDS TE
SD8	239PLF ADD'L SNOW DRIFT @ TE TO 0PLF, 17'-7" FROM TE		
SD11	244PLF ADD'L SNOW DRIFT @ 21'-3 3/4" FROM TE TO 0PLF (17'-0") TOWARDS NTE	SD33	261PLF ADD'L SNOW DRIFT @ 8'-3 3/4" FROM TE TO 0PLF (17'-0") TOWARDS NTE
SD12	244PLF ADD'L SNOW DRIFT @ 26'-3 1/4" FROM TE TO 0 PLF(17'-0") TOWARDS TE		

NOTE	DESCRIPTION	NOTE	DESCRIPTION
SD34	261PLF ADD'L SNOW DRIFT @ 37'-10 3/8 FROM NTE TO 0PLF (17'-0") TOWARDS NTE	SD53	ADD'L 7PLF AT 0' TO 8'-6" FTE(DUE TO RTU SNOW DRIFT)
SD35	261PLF ADD'L SNOW DRIFT @ 44'-2 5/8 FROM NTE TO 0PLF (17'-0") TOWARDS TE	SD54	ADD'L 162PLF @ 38'-8" TO 45'-0" FROM NTE (DUE TO SNOW DRIFT RTU)
SD36	261PLF ADD'L SNOW DRIFT @ 8'-6 3/4" FROM NTE TO 0PLF (17'-0") TOWARDS NTE	SD55	ADD'L 71PLF @ 38'-8" TO 45'-0" FROM NTE (DUE TO SNOW DRIFT LOAD)
SD37	261PLF ADD'L SNOW DRIFT @ 14'-11" FROM NTE TO 0PLF (17'-0") TOWARDS TE	SD56	ADD'L 7PLF @ 38'-8" TO 45'-0" FROM NTE (DUE TO SNOW DRIFT LOAD)
SD38	261PLF ADD'L SNOW DRIFT @ 28'-9 1/4 FROM NTE TO 0PLF (17'-0") TOWARDS NTE	SD57	ADD'L 162PLF @ 26'-4" TO 32'-9" FROM NTE (DUE TO SNOW DRIFT RTU)
SD39	261PLF ADD'L SNOW DRIFT @ 35'-1 1/2 FROM NTE TO 0PLF (17'-0") TOWARDS TE	SD58	ADD'L 71PLF @ 26'-4" TO 32'-9" FROM NTE (DUE TO SNOW DRIFT RTU)
SD40	244PLF ADD'L SNOW DRIFT @ 37'-4 1/2 FROM NTE TO 0PLF (17'-0") TOWARDS NTE	SD59	ADD'L 7PLF @ 26'-4" TO 32'-9" FROM NTE (DUE TO SNOW DRIFT RTU)
SD41	244PLF ADD'L SNOW DRIFT @ 43'-8 3/4 FROM NTE TO 0PLF (17'-0") TOWARDS TE	SD60	244PLF ADD'L SNOW DRIFT @ 8'-5 3/8" FROM TE TO 0 PLF(17'-0") TOWARDS TE
SD42	244PLF ADD'L SNOW DRIFT @ 7'-9 1/4 FROM NTE TO 0PLF (17'-0") TOWARDS NTE	SD61	244PLF ADD'L SNOW DRIFT @ 11'-7 3/8" FROM TE TO 0 PLF(17'-0") TOWARDS NTE
SD43	244PLF ADD'L SNOW DRIFT @ 14'-1 1/2 FROM NTE TO 0PLF (17'-0") TOWARDS TE	SD62	ADD'L 162PLF @ 8'-5" TO 11'-8 FROM TE (DUE TO RTU SNOW DRIFT)
SD44	244PLF ADD'L SNOW DRIFT @ 4'-9 3/4 FROM TE TO 0PLF (17'-0") TOWARDS TE	SD63	ADD'L 71PLF @ 8'-5" TO 11'-8 FROM TE (DUE TO RTU SNOW DRIFT)
SD45	244PLF ADD'L SNOW DRIFT @ 11'-2" FROM TE TO 0PLF (17'-0") TOWARDS NTE	SD64	ADD'L 7PLF @ 8'-5" TO 11'-8 FROM TE (DUE TO RTU SNOW DRIFT)
SD46	ADD'L 115PLF @ 0' TO 3'-2" FNTE (DUE TO RTU SNOW DRIFT)	SD65	ADD'L 162PLF @ 37'-10" TO 44'-3 FROM NTE (DUE TO RTU SNOW DRIFT)
SD47	ADD'L 162PLF AT 0' TO 3'-2" FTE(DUE TO RTU SNOW DRIFT)	SD66	ADD'L 71PLF @ 37'-10" TO 44'-3 FROM NTE (DUE TO RTU SNOW DRIFT)
SD48	ADD'L 71PLF AT 0' TO 3'-2" FTE(DUE TO RTU SNOW DRIFT)	SD67	ADD'L 7PLF @ 37'-10" TO 44'-3 FROM NTE (DUE TO RTU SNOW DRIFT)
SD49	ADD'L 7PLF AT 0' TO 3'-2" FTE(DUE TO RTU SNOW DRIFT)	SD68	ADD'L 162PLF @ 28'-9" TO 35'-2 FROM NTE (DUE TO RTU SNOW DRIFT)
SD50	ADD'L 115PLF AT 0' TO 8'-6" FTE OR 132PLF @ 8'-6" TO 0PLF AT 25'-6" FROM TE(DUE TO RTU SNOW DRIFT)	SD69	ADD'L 71PLF @ 28'-9" TO 35'-2 FROM NTE (DUE TO RTU SNOW DRIFT)
SD51	ADD'L 162PLF AT 0' TO 8'-6" FTE(DUE TO RTU SNOW DRIFT)	SD70	ADD'L 7PLF @ 28'-9" TO 35'-2 FROM NTE (DUE TO RTU SNOW DRIFT)
SD52	ADD'L 71PLF AT 0' TO 8'-6" FTE(DUE TO RTU SNOW DRIFT)	SD71	ADD'L 162PLF @ 8'-7" TO 15'-0 FROM NTE (DUE TO RTU SNOW DRIFT)
		SD72	ADD'L 71PLF @ 8'-7" TO 15'-0 FROM NTE (DUE TO RTU SNOW DRIFT)
		SD73	ADD'L 7PLF @ 8'-7" TO 15'-0 FROM NTE (DUE TO RTU SNOW DRIFT)
		SD74	ADD'L 162PLF @ 37'-4" TO 43'-9" FROM NTE (DUE TO RTU SNOW DRIFT)
		SD75	ADD'L 71PLF @ 37'-4" TO 43'-9" FROM NTE (DUE TO RTU SNOW DRIFT)
		SD76	ADD'L 7PLF @ 37'-4" TO 43'-9" FROM NTE (DUE TO RTU SNOW DRIFT)
		SD77	ADD'L 162PLF @ 7'-9" TO 14'-2" FROM NTE (DUE TO RTU SNOW DRIFT)
		SD78	ADD'L 71PLF @ 7'-9" TO 14'-2" FROM NTE (DUE TO RTU SNOW DRIFT)
		SD79	ADD'L 7PLF @ 7'-9" TO 14'-2" FROM NTE (DUE TO RTU SNOW DRIFT)
		SD80	ADD'L 162PLF @ 2'-4" TO 8'-8" FROM TE (DUE TO RTU SNOW DRIFT)

NOTE	DESCRIPTION	NOTE	DESCRIPTION
SD81	ADD'L 71PLF @ 2'-4" TO 8'-8" FROM TE (DUE TO RTU SNOW DRIFT)		
SD82	ADD'L 7PLF @ 2'-4" TO 8'-8" FROM TE (DUE TO RTU SNOW DRIFT)		
SD83	ADD'L 162PLF @ 14'-4" TO 20'-8" FROM TE (DUE TO RTU SNOW DRIFT)		
SD84	ADD'L 71PLF @ 14'-4" TO 20'-8" FROM TE (DUE TO RTU SNOW DRIFT)		
SD85	ADD'L 7PLF @ 14'-4" TO 20'-8" FROM TE (DUE TO RTU SNOW DRIFT)		
SD86	ADD'L 162PLF @ 16'-9" TO 23'-1" FROM TE (DUE TO RTU SNOW DRIFT)		
SD87	ADD'L 71PLF @ 16'-9" TO 23'-1" FROM TE (DUE TO RTU SNOW DRIFT)		
SD88	ADD'L 7PLF @ 16'-9" TO 23'-1" FROM TE (DUE TO RTU SNOW DRIFT)		
SD89	ADD'L 162PLF @ 17'-3" TO 23'-7" FROM TE (DUE TO RTU SNOW DRIFT)		
SD90	ADD'L 71PLF @ 17'-3" TO 23'-7" FROM TE (DUE TO RTU SNOW DRIFT)		
SD91	ADD'L 7PLF @ 17'-3" TO 23'-7" FROM TE (DUE TO RTU SNOW DRIFT)		
SD92	ADD'L 162PLF @ 7'-7" TO 14'-0" FROM TE (DUE TO RTU SNOW DRIFT)		
SD93	ADD'L 71PLF @ 7'-7" TO 14'-0" FROM TE (DUE TO RTU SNOW DRIFT)		
SD94	ADD'L 7PLF @ 7'-7" TO 14'-0" FROM TE (DUE TO RTU SNOW DRIFT)		
SD95	ADD'L 162PLF @ 35'-10" TO 42'-2" FROM NTE (DUE TO RTU SNOW DRIFT)		
SD96	ADD'L 71PLF @ 35'-10" TO 42'-2" FROM TE (DUE TO RTU SNOW DRIFT)		
SD97	ADD'L 7PLF @ 35'-10" TO 42'-2" FROM TE (DUE TO RTU SNOW DRIFT)		
SP1	ADD'L PIPE LOAD OF 32PLF ALONG TC (DUE TO 6" MAIN)		
SP2	ADD'L PIPE LOAD OF 64PLF ALONG TC (DUE TO 2-6" MAINS)		
SP3	ADD'L PIPE LOAD OF 0.3K ANYWHERE ALONG TC (DUE TO 8" MAIN)		
SP4	ADD'L PIPE LOAD OF 0.2K ANYWHERE ALONG TC (DUE TO 6" MAIN)		
SP5	2-ADD'L PIPE LOAD OF 0.2K (+0.4K TOTAL) ALONG TC (DUE TO 2-6" MAINS)		
UP1	NO UPLIFT, FLOOR JOIST		
J-SHL1	7/8" X 1 1/2" - 4" GA		
J-SHR1	7/8" X 1 1/2" - 4" GA		

		NOTES:																				
SEQUENCE	COLOR																					
QTY	MARK	1	2	3	4	5	6	7	8	9	10	11	12	13	14	15	16	17	18	19	20	21
5	J21	--	--	--	--	--	--	--	2	1	--	--	--	--	--	--	--	1	--	1	--	
6	J22	--	--	--	--	--	--	--	1	1	--	--	--	--	1	--	--	2	--	1	--	
8	J23	--	--	--	--	--	--	--	1	1	--	--	--	--	2	--	--	2	--	2	--	
1	J24	--	--	--	--	--	--	--	1	--	--	--	--	--	--	--	--	--	--	--	--	
1	J25	--	--	--	--	--	--	--	1	--	--	--	--	--	--	--	--	--	--	--	--	
4	TJ26	--	--	--	--	--	--	--	1	--	--	--	--	--	1	--	--	1	--	1	--	
5	J27	--	--	--	--	--	--	--	--	1	--	--	--	--	--	--	--	2	--	2	--	
18	J28	--	--	--	6	--	--	--	--	6	--	--	--	--	--	--	6	--	--	--	--	
15	J29	--	--	--	2	2	--	--	--	3	1	--	--	--	1	--	1	3	--	1	1	
45	J30	--	--	--	7	4	--	--	--	7	4	--	--	--	--	2	4	3	--	13	--	
1	J31	--	--	--	--	--	--	--	--	1	--	--	--	--	--	--	--	--	--	--	--	
4	TJ32	--	--	--	1	--	--	--	--	1	--	--	--	--	--	--	--	--	2	--	--	
5	J33	--	--	--	1	1	--	--	--	1	1	--	--	--	--	1	--	--	--	--	--	
5	J34	--	--	--	1	1	--	--	--	1	1	--	--	--	--	1	--	--	--	--	--	
4	J35	--	--	--	1	--	--	--	--	1	1	--	--	--	--	1	--	--	--	--	--	
2	J36	--	--	--	1	--	--	--	--	1	--	--	--	--	--	--	--	--	--	--	--	
2	TJ37	--	--	--	1	--	--	--	--	1	--	--	--	--	--	--	--	--	--	--	--	
2	TJ38	--	--	--	--	--	--	--	--	1	--	--	--	--	1	--	--	--	--	--	--	
1	TJ39	--	--	--	--	--	--	--	--	1	--	--	--	--	--	--	--	--	--	--	--	
3	J40	--	--	--	--	--	--	--	--	3	--	--	--	--	--	--	--	--	--	--	--	
137	TOTAL	--	--	--	21	8	--	--	7	27	13	--	--	--	5	2	9	13	7	17	7	

NOTES:


																					NOTES:	
SEQUENCE COLOR																						
QTY	MARK	1	2	3	4	5	6	7	8	9	10	11	12	13	14	15	16	17	18	19	20	21
1	J41	—	—	—	—	—	—	—	—	—	1	—	—	—	—	—	—	—	—	—	—	
1	J42	—	—	—	—	—	—	—	—	—	1	—	—	—	—	—	—	—	—	—	—	
1	J43	—	—	—	—	—	—	—	—	—	1	—	—	—	—	—	—	—	—	—	—	
1	J44	—	—	—	—	—	—	—	—	—	1	—	—	—	—	—	—	—	—	—	—	
1	J45	—	—	—	—	—	—	—	—	—	1	—	—	—	—	—	—	—	—	—	—	
1	TJ46	—	—	—	—	—	—	—	—	—	1	—	—	—	—	—	—	—	—	—	—	
1	J47	—	—	—	—	—	—	—	—	—	—	1	—	—	—	—	—	—	—	—	—	
1	J48	—	—	—	—	—	—	—	—	—	—	1	—	—	—	—	—	—	—	—	—	
1	J49	—	—	—	—	—	—	—	—	—	—	1	—	—	—	—	—	—	—	—	—	
171	J143	20	18	20	---	---	---	7	---	---	23	14	24	19	19	7	---	---	---	---	---	
21	TJ144	4	2	3	---	---	---	---	---	---	2	2	3	2	3	---	---	---	---	---	---	
17	J145	4	---	4	---	---	---	---	---	1	4	---	2	2	---	---	---	---	---	---	---	
16	J146	---	6	---	---	---	---	---	---	---	6	---	1	3	---	---	---	---	---	---	---	
1	TJ147	---	---	---	---	---	---	---	---	1	---	---	---	---	---	---	---	---	---	---	---	
2	J148	---	---	---	---	---	---	---	---	---	---	2	---	---	---	---	---	---	---	---	---	
2	J149	---	---	---	---	---	---	1	---	---	---	---	---	---	---	---	---	---	---	---	1	
2	J150	---	---	---	---	---	---	1	---	---	---	---	---	---	---	---	---	---	---	---	1	
2	J151	---	---	---	---	---	---	1	---	---	---	---	---	---	---	---	---	---	---	---	1	
2	J152	---	---	---	---	---	---	1	---	---	---	---	---	---	---	---	---	---	---	---	1	
6	J153	---	---	---	---	---	---	3	---	---	---	---	---	---	---	---	---	---	---	---	3	
1	TJ154	---	---	---	---	---	1	---	---	---	---	---	---	---	---	---	---	---	---	---	---	
2	J155	---	---	---	---	---	---	1	---	---	---	---	---	---	---	---	---	---	---	---	1	
171	J156	20	18	20	---	---	---	7	---	---	---	---	---	---	23	14	24	19	19	7	---	
18	TJ157	4	2	3	---	---	---	---	---	---	---	---	---	---	2	2	3	2	---	---	---	
17	J158	4	---	4	---	---	---	---	---	---	---	---	---	---	1	4	---	2	2	---	---	
16	J159	---	6	---	---	---	---	---	---	---	---	---	---	---	6	---	1	3	---	---	---	
1	TJ160	---	---	---	---	---	---	---	---	---	---	---	---	---	1	---	---	---	---	---	---	
472	TOTAL	56	52	54	---	---	16	9	---	---	27	26	27	26	27	9	27	26	27	24	24	15


																				NOTES:				
SEQUENCE COLOR		1	2	3	4	5	6	7	8	9	10	11	12	13	14	15	16	17	18	19	20	21		
QTY	MARK	1	2	3	4	5	6	7	8	9	10	11	12	13	14	15	16	17	18	19	20	21		
2	J161	—	—	—	—	—	—	—	—	—	—	—	—	—	—	—	—	—	2	—	—			
3	TJ162	—	—	—	—	—	—	—	—	—	—	—	—	—	—	—	—	—	—	3	—			
1	TJ163	—	—	—	—	—	—	—	—	—	—	—	—	—	—	—	—	—	—	—	1			
4	J164	—	—	—	—	—	3	—	—	—	—	—	—	—	—	—	—	—	—	—	1			
4	J165	—	—	—	—	—	3	—	—	—	—	—	—	—	—	—	—	—	—	—	1			
3	J166	—	—	—	—	—	3	—	—	—	—	—	—	—	—	—	—	—	—	—	—			
3	J167	—	—	—	—	—	3	—	—	—	—	—	—	—	—	—	—	—	—	—	—			
12	J168	—	—	—	—	—	9	—	—	—	—	—	—	—	—	—	—	—	—	—	3			
4	TJ169	—	—	—	—	—	3	—	—	—	—	—	—	—	—	—	—	—	—	—	1			
4	J170	—	—	—	—	—	3	—	—	—	—	—	—	—	—	—	—	—	—	—	1			
513	J171	60	54	60	—	—	21	—	—	—	—	—	—	—	69	42	72	57	57	21	—			
63	TJ172	12	6	9	—	—	—	—	—	—	—	—	—	—	6	6	9	6	9	—	—			
51	J173	12	—	12	—	—	—	—	—	—	—	—	—	—	3	12	—	6	6	—	—			
48	J174	—	18	—	—	—	—	—	—	—	—	—	—	—	18	—	3	9	—	—	—			
3	TJ175	—	—	—	—	—	—	—	—	—	—	—	—	—	3	—	—	—	—	—	—			
6	J176	—	—	—	—	—	—	—	—	—	—	—	—	—	—	—	—	6	—	—	—			
1	J177	—	—	—	—	—	—	—	—	—	—	—	—	—	—	—	—	—	—	1	—			
1	J178	—	—	—	—	—	—	—	—	—	—	—	—	—	—	—	—	—	—	—	1			
1	J179	—	—	—	—	—	—	—	—	—	—	—	—	—	—	—	—	—	—	—	1			
1	TJ180	—	—	—	—	—	—	—	—	—	—	—	—	—	—	—	—	—	—	—	1			
728	TOTAL	84	78	81	—	—	48	—	—	—	—	—	—	—	81	78	81	80	84	33	—			

																				NOTES:				
SEQUENCE COLOR		1	2	3	4	5	6	7	8	9	10	11	12	13	14	15	16	17	18	19	20	21		
QTY	MARK	1	2	3	4	5	6	7	8	9	10	11	12	13	14	15	16	17	18	19	20	21		
1	J201	---	---	---	---	1	---	---	---	---	---	---	---	---	---	---	---	---	---	---	---	---		
1	J202	---	---	---	1	---	---	---	---	---	---	---	---	---	---	---	---	---	---	---	---	---		
4	TJ203	---	---	2	---	---	---	---	---	---	---	---	---	---	1	---	1	---	---	---	---	---		
7	J204	---	---	2	---	---	---	---	---	---	---	---	---	1	---	2	---	2	---	---	---	---		
16	J205	---	---	6	---	---	---	---	---	---	---	---	---	6	---	1	3	---	---	---	---	---		
6	J206	---	---	1	---	---	---	---	---	---	---	---	---	1	---	2	---	2	---	---	---	---		
3	J207	---	---	1	---	---	---	---	---	---	---	---	---	---	1	---	1	1	---	---	---	---		
1	TJ208	1	---	---	---	---	---	---	---	---	---	---	---	1	---	---	---	---	---	---	---	---		
2	J209	---	---	---	---	---	---	---	---	---	---	---	---	---	---	2	---	---	---	---	---	---		
1	J210	---	---	---	---	---	---	---	---	---	---	---	---	---	---	1	---	---	---	---	---	---		
1	J211	---	---	---	---	---	---	---	---	---	---	---	---	---	---	1	---	---	---	---	---	---		
1	TJ212	---	---	---	---	---	---	---	---	---	---	---	---	---	---	---	1	---	---	---	---	---		
2	J213	---	---	---	---	---	---	---	---	---	---	---	---	---	---	---	2	---	---	---	---	---		
1	J214	---	---	---	---	---	---	---	---	---	---	---	---	---	---	---	1	---	---	---	---	---		
1	J215	---	---	---	---	---	---	---	---	---	---	---	---	---	---	1	---	---	---	---	---	---		
1	J216	---	---	---	---	---	---	---	---	---	---	---	---	---	---	1	---	---	---	---	---	---		
1	J217	---	---	---	---	---	---	---	---	---	---	---	---	---	---	1	---	---	---	---	---	---		
1	J218	---	---	---	---	---	---	---	---	---	---	---	---	---	---	1	---	---	---	---	---	---		
1	J219	---	---	1	---	---	---	---	---	---	---	---	---	---	---	---	---	---	---	---	---	---		
1	J220	---	---	1	---	---	---	---	---	---	---	---	---	---	---	---	---	---	---	---	---	---		
53	TOTAL	---	---	12	4	---	---	---	---	---	---	---	---	3	6	6	3	10	9	---	---	---	---	

																					NOTES:				
SEQUENCE COLOR																									
QTY	MARK	1	2	3	4	5	6	7	8	9	10	11	12	13	14	15	16	17	18	19	20	21			
2	J221	---	---	---	---	2	---	---	---	---	---	---	---	---	---	---	---	---	---	---	---	---			
1	TJ222	---	---	---	---	1	---	---	---	---	---	---	---	---	---	---	---	---	---	---	---	---			
1	J223	---	---	---	---	1	---	---	---	---	---	---	---	---	---	---	---	---	---	---	---	---			
1	J224	---	---	---	---	1	---	---	---	---	---	---	---	---	---	---	---	---	---	---	---	---			
1	TJ225	---	---	---	1	---	---	---	---	---	---	---	---	---	---	---	---	---	---	---	---	---			
1	J226	---	---	---	1	---	---	---	---	---	---	---	---	---	---	---	---	---	---	---	---	---			
1	J227	---	---	---	1	---	---	---	---	---	---	---	---	---	---	---	---	---	---	---	---	---			
1	J228	---	---	---	1	---	---	---	---	---	---	---	---	---	---	---	---	---	---	---	---	---			
3	J229	---	---	---	2	---	---	---	---	---	---	---	---	---	---	---	---	---	1	---	---	---			
1	J230	---	---	---	1	---	---	---	---	---	---	---	---	---	---	---	---	---	---	---	---	---			
1	J231	---	---	---	1	---	---	---	---	---	---	---	---	---	---	---	---	---	1	---	---	---			
1	TJ232	---	---	---	---	---	---	---	---	---	---	---	---	---	---	---	---	---	1	---	---	---			
2	J233	---	---	---	---	---	---	---	---	---	---	---	---	---	---	---	---	---	2	---	---	---			
1	J234	---	---	---	---	---	---	---	---	---	---	---	---	---	---	---	---	---	1	---	---	---			
1	J235	---	---	---	1	---	---	---	---	---	---	---	---	---	---	---	---	---	1	---	---	---			
1	J236	---	---	---	1	---	---	---	---	---	---	---	---	---	---	---	---	---	1	---	---	---			
1	J237	---	---	---	1	---	---	---	---	---	---	---	---	---	---	---	---	---	1	---	---	---			
1	J238	---	---	---	---	---	---	---	---	---	---	---	---	---	---	---	---	---	1	---	---	---			
1	J239	---	---	---	---	---	---	---	---	---	---	---	---	---	---	---	---	---	1	---	---	---			
1	J240	---	---	---	---	---	---	---	---	---	---	---	---	---	---	---	---	---	1	---	---	---			
24	TOTAL	---	---	---	7	8	---	---	---	---	---	---	---	---	---	---	---	---	1	---	8	---	---	---	---

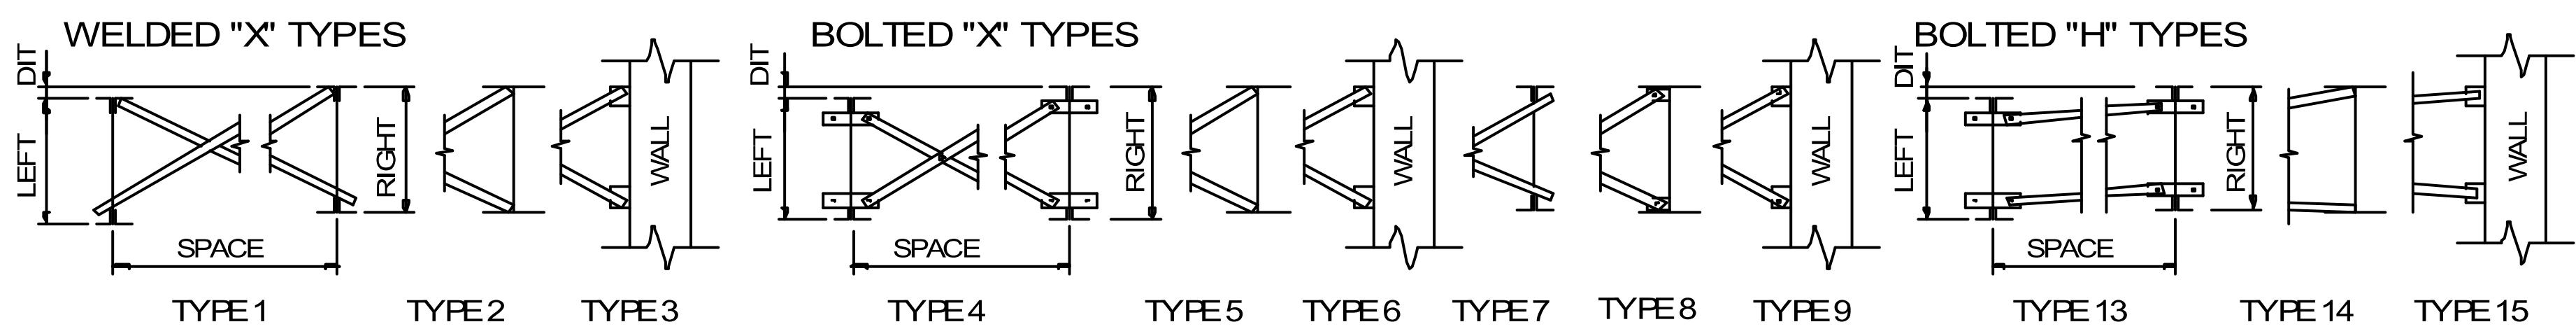

NOTE FOR "DIT" USE "+" WHEN "LEFT" IS LOWER THAN "RIGHT" & USE "-" WHEN "RIGHT" IS LOWER THAN "LEFT"

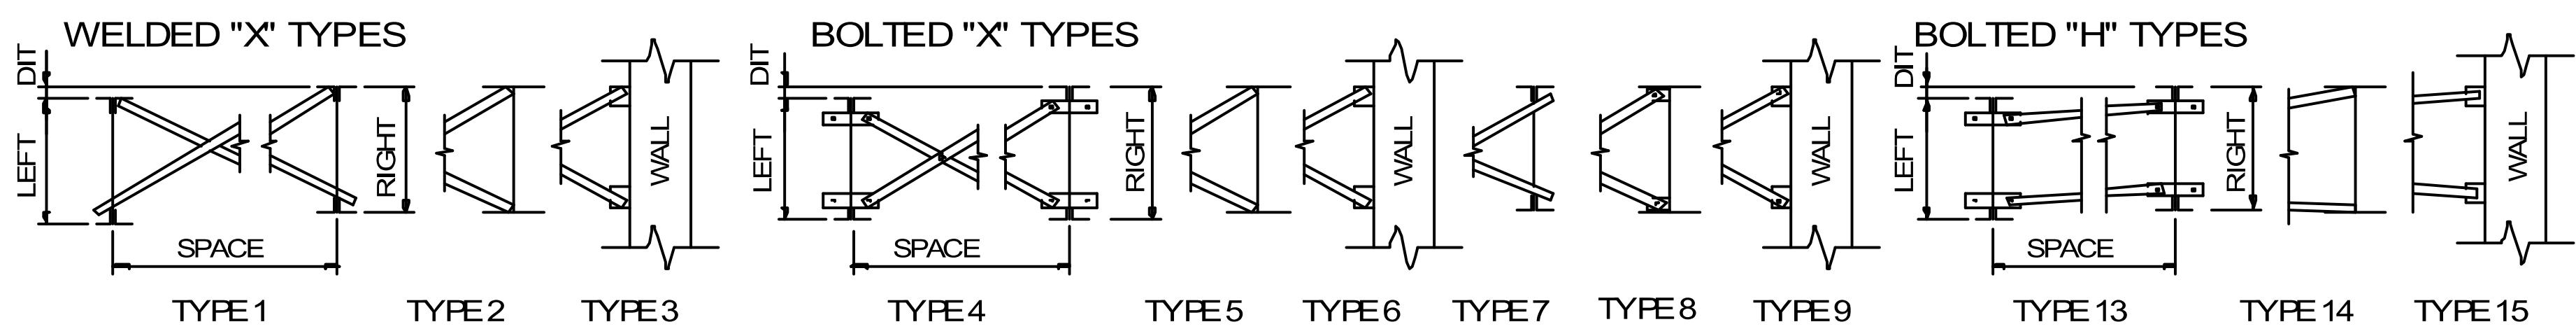

NOTE FOR "DIT" USE "+" WHEN "LEFT" IS LOWER THAN "RIGHT" & USE "-" WHEN "RIGHT" IS LOWER THAN "LEFT"

SEQUENCE				QTY	MARK	TYPE	LEFT MARK	LEFT DEPTH	RIGHT MARK	RIGHT DEPTH	SPACING	DIT = DIFF IN TOP	SIZE	REMARKS	SEQUENCE				HORIZONTAL BRIDGING							
															QTY	MARK	LENGTH	SIZE	REMARKS							
---	---	---	---	6	800	022		44"		44"	5'-9 3/4"	0"	L 1 1/4 x 0.109													
---	---	---	---	6	801																					
---	---	---	---	6	802	022		44"		44"	5'-10 1/2"	0"	L 1 1/4 x 0.109													
---	---	---	---	6	803																					
---	---	---	---	2	804	022		30"		30"	5'-9 3/4"	0"	L 1 1/4 x 0.109													
---	---	---	---	2	805											SEQUENCE				BRIDGING ANCHORCLIPS						
---	---	---	---	2	806	022		30"		30"	5'-10 1/2"	0"	L 1 1/4 x 0.109				QTY	MARK	LENGTH	SIZE	REMARKS					
---	---	---	---	2	807																					
---	---	---	---	8	808	022		30"		30"	4'-11 3/4"	0"	L 1 1/4 x 0.109													
---	---	---	---	8	809																					
---	---	---	---	8	810	022		30"		30"	5'-0 1/2"	0"	L 1 1/4 x 0.109				SEQUENCE				GIRDER KNEE BRACE / LOOSE BOTTOM CHORD					
---	---	---	---	8	811												QTY	MARK	LENGTH	SIZE	GIRD ER DEPT H	JOST DEPTH	SEAT DEPTH			
																	SEQUENCE		BOLT/NUT/WASHER			SEQUENCE		BOLT/NUT/WASHER		
																	QTY	SIZE			QTY	SIZE				

